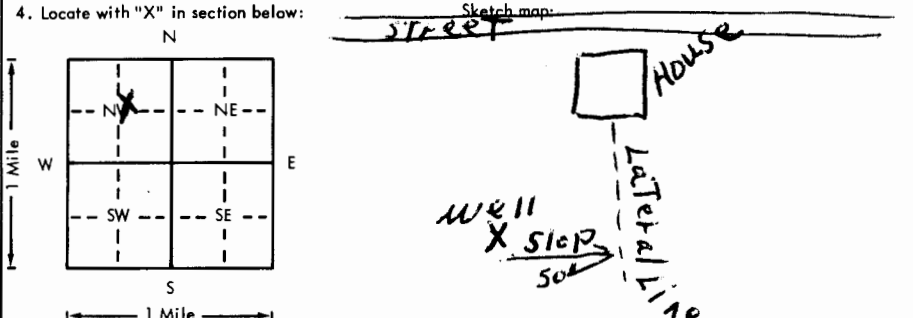


USE TYPEWRITER OR BALL POINT PEN—PRESS FIRMLY, PRINT CLEARLY.

WATER WELL RECORD
KSA 82a-1201-1215

Kansas Department of Health and Environment—Division of Environment
(Water well Contractors)
Topeka, Kansas 66620

1. Location of well:		County COWLEY	Fraction 1/4 1/4 1/4	Tract NW/4	Section number 4	Township number T 33	Range number S R 4	EW
2. Distance and direction from nearest town or city: 1 mile south, 1/4 mile west, 1/4 south of Winfield, Kansas				3. Owner of well: Ralph Lankton				
Street address of well location if in city: Route 3 (Lot 6, Sunrise Acres) Winfield, Kans.				R.R. or street: Route 3				
City, state, zip code: Winfield, Kansas 67156								
4. Locate with "X" in section below: 				6. Bore hole dia. 10 in. Completion date 7/27/77 Well depth 90 ft.				
5. Type and color of material				From	To	7. <input checked="" type="checkbox"/> Cable tool <input type="checkbox"/> Rotary <input type="checkbox"/> Driven <input type="checkbox"/> Dug <input type="checkbox"/> Hollow rod <input type="checkbox"/> Jetted <input type="checkbox"/> Bored <input type="checkbox"/> Reverse rotary		
Top Soil				0	5	8. Use: <input type="checkbox"/> Domestic <input type="checkbox"/> Public supply <input type="checkbox"/> Industry <input type="checkbox"/> Irrigation <input type="checkbox"/> Air conditioning <input type="checkbox"/> Stock <input checked="" type="checkbox"/> Lawn <input type="checkbox"/> Oil field water <input type="checkbox"/> Other		
White Lime				5	15	9. Casing: Material plts Height: Above or below Threaded <input type="checkbox"/> Welded <input type="checkbox"/> Surface 24 in. RMP <input type="checkbox"/> PVC <input type="checkbox"/> Weight <input type="checkbox"/> lbs./ft. Dia. 5 in. to 90 ft. depth Wall Thickness: inches or Dia. <input type="checkbox"/> in. to <input type="checkbox"/> ft. depth gage No. #200		
White Lime Shale				15	40	10. Screen: Manufacturer's name Jess & Lowell Type plastic Dia. 5" <input checked="" type="checkbox"/> Slot/gauze 1/16 Length 10 ft. Set between 80 ft. and 90 ft. <input type="checkbox"/> ft. and <input type="checkbox"/> ft. Gravel pack? yes Size range of material 5/8" max.		
Blue Shale				40	50	11. Static water level: <input type="checkbox"/> mo./day/yr. 48 ft. below land surface Date 7/27/77		
Red Bed				50	55	12. Pumping level below land surfaces: Bailer test <input type="checkbox"/> ft. after <input type="checkbox"/> hrs. pumping <input type="checkbox"/> g.p.m. <input type="checkbox"/> ft. after <input type="checkbox"/> hrs. pumping <input type="checkbox"/> g.p.m. Estimated maximum yield 9 g.p.m.		
Blue Shale				55	60	13. Water sample submitted: <input type="checkbox"/> mo./day/yr. <input type="checkbox"/> Yes <input checked="" type="checkbox"/> No Date		
Lime Shale				60	70	14. Well head completion: <input type="checkbox"/> Pitless adapter 24 Inches above grade		
Blue Shale				70	90	15. Well grouted? yes With: <input checked="" type="checkbox"/> Neat cement <input type="checkbox"/> Bentonite <input type="checkbox"/> Concrete Depth: From 0 ft. to 17 ft.		
(Use a second sheet if needed)						16. Nearest source of possible contamination: ft. 50 Direction east Type lateral line Well disinfected upon completion? <input checked="" type="checkbox"/> Yes <input type="checkbox"/> No		
						17. Pump: <input checked="" type="checkbox"/> Not installed Manufacturer's name Model number <input type="checkbox"/> HP <input type="checkbox"/> Volts Length of drop pipe <input type="checkbox"/> ft. capacity <input type="checkbox"/> g.p.m. Type: <input type="checkbox"/> Submersible <input type="checkbox"/> Turbine <input type="checkbox"/> Jet <input type="checkbox"/> Reciprocating <input type="checkbox"/> Centrifugal <input type="checkbox"/> Other		
18. Elevation:		19. Remarks:		20. Water well contractor's certification: This well was drilled under my jurisdiction and this report is true to the best of my knowledge and belief. Ronal Heffron Drilling #113 Business name Address Route 3, Winfield, KS. 67156 Signed Ronal Heffron Date 7/27/77 Authorized representative				
Topography: <input type="checkbox"/> Hill <input type="checkbox"/> Slope <input checked="" type="checkbox"/> Upland <input type="checkbox"/> Valley		Concrete Slab to be installed by customer at surface of ground. He knows this is a regulation. <i>Ralph A. Lankton</i>						

T
R
S
E
C
1/4
1/4
1/4
1/4

Forward the white, blue and pink copies to the Department of Health and Environment

Form WWC-5