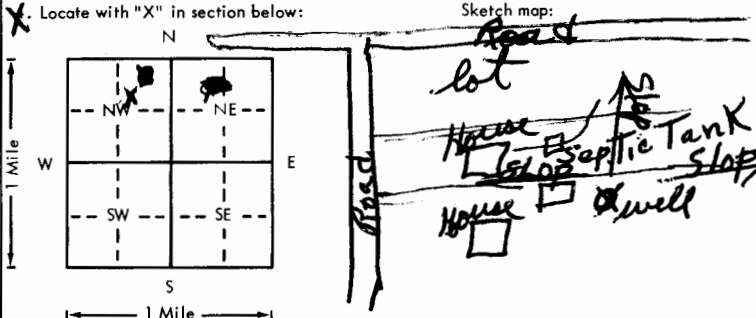
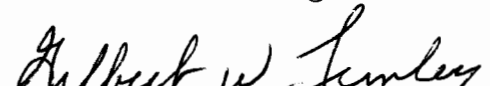


USE TYPEWRITER OR BALL
POINT PEN-PRESS FIRMLY,
PRINT CLEARLY.

WATER WELL RECORD
KSA 82a-1201-1215

Kansas Department of Health and
Environment-Division of Environment
(Water well Contractors)
Topeka, Kansas 66620

1. Location of well:		County Cowley	Fraction SW 1/4 NE 1/4	Section number 4	Township number T 33 N 4 E	Range number R 4 E
2. Distance and direction from nearest town or city: approx. 1/4 Mi West of Winfield, Kansas		3. Owner of well: Gilbert Finley R.R. or street: Route 5 City, state, zip code: Winfield, Kansas 67156				
4. Locate with "X" in section below: 		6. Bore hole dia. 10 in. Completion date 11/19/78 Well depth 135 ft.				
5. Type and color of material		7. <input checked="" type="checkbox"/> Cable tool <input type="checkbox"/> Rotary <input type="checkbox"/> Driven <input type="checkbox"/> Dug <input type="checkbox"/> Hollow rod <input type="checkbox"/> Jetted <input type="checkbox"/> Bored <input type="checkbox"/> Reverse rotary				
		8. Use: <input type="checkbox"/> Domestic <input type="checkbox"/> Public supply <input type="checkbox"/> Industry <input type="checkbox"/> Irrigation <input type="checkbox"/> Air conditioning <input type="checkbox"/> Stock <input checked="" type="checkbox"/> Lawn <input type="checkbox"/> Oil field water <input type="checkbox"/> Other				
		9. Casing: Material pvc Height: above or below Threaded <input type="checkbox"/> Welded <input type="checkbox"/> Surface 24 in. RMP <input type="checkbox"/> PVC <input checked="" type="checkbox"/> Weight <input type="checkbox"/> lbs./ft. Dia. 5 in. to 135 ft. depth Wall thickness: inches or Dia. <input type="checkbox"/> in. to <input type="checkbox"/> ft. depth gage No. Schedule 40				
		10. Screen: Manufacturer's name unknown Type PVC Dia. 5" <input checked="" type="checkbox"/> gauze 1/16 Length 10 ft Set between 125' ft. and 135' ft. ft. and <input type="checkbox"/> ft. Gravel pack? yes Size range of material 5/8"				
		11. Static water level: <input type="checkbox"/> mo./day/yr. 65 ft. below land surface Date 11/19/78				
(Use a second sheet if needed)		12. Pumping level below land surfaces: bailer test <input type="checkbox"/> ft. after <input type="checkbox"/> hrs. pumping <input type="checkbox"/> g.p.m. <input type="checkbox"/> ft. after <input type="checkbox"/> hrs. pumping <input type="checkbox"/> g.p.m. Estimated maximum yield 5 g.p.m.				
		13. Water sample submitted: <input type="checkbox"/> mo./day/yr. <input type="checkbox"/> Yes <input checked="" type="checkbox"/> No Date <input type="checkbox"/>				
		14. Well head completion: <input type="checkbox"/> Pitless adapter 24 inches above grade				
		15. Well grouted? yes With: <input checked="" type="checkbox"/> Neat cement <input type="checkbox"/> Bentonite <input type="checkbox"/> Concrete Depth: From 0 ft. to 15 ft.				
		16. Nearest source of possible contamination: sewer line ft. 125 Direction North Type <input type="checkbox"/> Well disinfected upon completion? <input checked="" type="checkbox"/> Yes <input type="checkbox"/> No				
18. Elevation: unknown		19. Remarks: Concrete Slab to be installed by customer at surface of ground. He knows this is a regulation. 		20. Water well contractor's certification: This well was drilled under my jurisdiction and this report is true to the best of my knowledge and belief. Ronal Heffron Drilling #113 Business name Winfield, Kans. 67156 No. Address Ronal Heffron Signed Ronal Heffron Date 12-4-78 Authorized representative		

Forward the white, blue and pink copies to the Department of Health and Environment

Form WWC-5