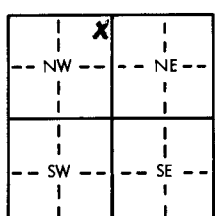
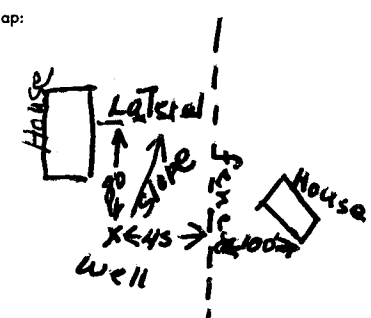


USE TYPEWRITER OR BALL
POINT PEN—PRESS FIRMLY,
PRINT CLEARLY.

WATER WELL RECORD
KSA 820-1201-1215

Kansas Department of Health and
Environment-Division of Environment
(Water well Contractors)
Topeka, Kansas 66620

1. Location of well: <div style="text-align: center; font-size: 1.2em;">Cowley</div>		Fraction <div style="text-align: center;">NE 1/4 NE 1/4 NW 1/4</div>		Section number <div style="text-align: center; font-size: 1.2em;">5</div>		Township number <div style="text-align: center;">T 33 S R 4</div>		Range number <div style="text-align: center;">E/W</div>	
2. Distance and direction from nearest town or city: 1 mile south; 1 mi. west of Winfield, Kansas <small>Street address of well location if in city:</small>				3. Owner of well: Joe Collins R.R. or street: Route 3 City, state, zip code: Winfield, Kansas 67156					
4. Locate with "X" in section below: <div style="text-align: center;">N 1 Mile W 1 Mile S E</div> 				Sketch map: 		6. Bore hole dia. 10 in. Completion date 8/18/77 Well depth 124 ft.			
5. Type and color of material				From		To		7. <input checked="" type="checkbox"/> Cable tool <input type="checkbox"/> Rotary <input type="checkbox"/> Driven <input type="checkbox"/> Dug <input type="checkbox"/> Hollow rod <input type="checkbox"/> Jetted <input type="checkbox"/> Bored <input type="checkbox"/> Reverse rotary	
								8. Use: <input checked="" type="checkbox"/> Domestic <input type="checkbox"/> Public supply <input type="checkbox"/> Industry <input type="checkbox"/> Irrigation <input type="checkbox"/> Air conditioning <input type="checkbox"/> Stock <input type="checkbox"/> Lawn <input type="checkbox"/> Oil field water <input type="checkbox"/> Other	
Top Soil				0		5		9. Casing: Material Plts Height: Above or below Threaded <input type="checkbox"/> Welded <input type="checkbox"/> Surface 24 in. RMP <input type="checkbox"/> PVC <input type="checkbox"/> Weight <input type="checkbox"/> lbs./ft. Dia. 6 in. to 124 ft. depth Wall Thickness: inches or Dia. <input type="checkbox"/> in. to <input type="checkbox"/> ft. depth gage No. #200	
								10. Screen: Manufacturer's name Jones & Jess & Lowell Type Plts Dia. 6" <input checked="" type="checkbox"/> Slot gauze 1/16 Length 20 ft. Set between 124 ft. and 104 ft. <input type="checkbox"/> ft. and <input type="checkbox"/> ft. Gravel pack? yes Size range of material 5/8" max	
White Lime				5		25		11. Static water level: <input type="checkbox"/> mo./day/yr. 85 ft. below land surface Date 8-18-77	
Blue Shale				25		35		12. Pumping level below land surfaces: bailer test <input type="checkbox"/> ft. after <input type="checkbox"/> hrs. pumping <input type="checkbox"/> g.p.m. <input type="checkbox"/> ft. after <input type="checkbox"/> hrs. pumping <input type="checkbox"/> g.p.m. Estimated maximum yield 20 g.p.m.	
White Lime & Shale				35		40		13. Water sample submitted: <input type="checkbox"/> mo./day/yr. <input type="checkbox"/> Yes <input checked="" type="checkbox"/> No Date <input type="checkbox"/>	
Blue Shale				40		75		14. Well head completion: <input type="checkbox"/> Pitless adapter 24 inches above grade	
Lime (white)				75		100		15. Well grouted? yes With: <input checked="" type="checkbox"/> Neat cement <input type="checkbox"/> Bentonite <input type="checkbox"/> Concrete Depth: From 0 ft. to 12 ft.	
Blue Shale				100		124		16. Nearest source of possible contamination: ft. 80 Direction north Type lateral Well disinfected upon completion? <input checked="" type="checkbox"/> Yes <input type="checkbox"/> No	
(Use a second sheet if needed)								17. Pump: <input checked="" type="checkbox"/> Not installed Manufacturer's name <input type="checkbox"/> Model number <input type="checkbox"/> HP <input type="checkbox"/> Volts <input type="checkbox"/> Length of drop pipe <input type="checkbox"/> ft. capacity <input type="checkbox"/> g.p.m. Type: <input type="checkbox"/> Submersible <input type="checkbox"/> Turbine <input type="checkbox"/> Jet <input type="checkbox"/> Reciprocating <input type="checkbox"/> Centrifugal <input type="checkbox"/> Other	
								18. Elevation:	
								19. Remarks: <div style="text-align: center; font-size: 1.5em;">Joe E Collins</div> Concrete Slab to be installed by customer at surface of ground. He knows this is a regulation.	
								20. Water well contractor's certification: This well was drilled under my jurisdiction and this report is true to the best of my knowledge and belief. Ronal Heffron Drilling #113 Business name <input type="checkbox"/> License No. <input type="checkbox"/> Address Route 3, Winfield, Kans. 6 Signed Ronal Heffron Date 8/18 Authorized representative	
								Topography: <input type="checkbox"/> Hill <input type="checkbox"/> Slope <input checked="" type="checkbox"/> Upland <input type="checkbox"/> Valley	

Forward the white, blue and pink copies to the Department of Health and Environment

Form WWC-5