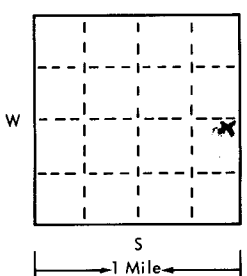
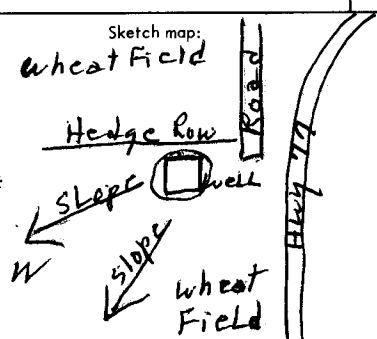


USE TYPEWRITER OR BALL POINT PEN—PRESS FIRMLY, PRINT CLEARLY.

T R EW sec 1/4 1/4 1/4 No.

WATER WELL RECORD  
KSA 82a-1201-1215

Kansas State Dept. Of Health  
(Water Well Contractors)  
Forbes-Bldg. 740  
Topeka, Kansas 66620

1 Location of well:	County <b>Cowley</b>	Township name <b>Pleasant Valley</b>	Fraction <b>NE 1/4 NE 1/4 SE 1/4</b>	Section number <b>7</b>	Town number <b>T33 S</b>	Range number <b>R4 E</b>	
Distance and direction from nearest town or city: <b>2 miles north of Hackney on Hwy 77.</b>			3 Owner of well: <b>Richard Beach</b> Address: <b>Route 2 Winfield, Kansas 67156</b>				
Locate with "X" in section below: 			Sketch map: 			4 Well depth: <b>115</b> ft. Date of completion <b>11-18-75</b> Well diameter <b>11</b> in.	
			5 <input checked="" type="checkbox"/> Cable tool <input type="checkbox"/> Rotary <input type="checkbox"/> Driven <input type="checkbox"/> Dug <input type="checkbox"/> Hollow rod <input type="checkbox"/> Jetted <input type="checkbox"/> Bored <input type="checkbox"/> Reverse rotary				
			6 Use: <input checked="" type="checkbox"/> Domestic <input type="checkbox"/> Public supply <input type="checkbox"/> Industry <input type="checkbox"/> Irrigation <input type="checkbox"/> Air conditioning <input type="checkbox"/> Commercial <input type="checkbox"/> Test well <input type="checkbox"/>				
			7 Casing: Material <b>Plastic</b> Height: above/below <input checked="" type="checkbox"/> Welded <input type="checkbox"/> Surface <b>24</b> in. Diam. <b>5</b> in. to <b>115</b> ft. depth! Drive shoe? <input type="checkbox"/> Yes <input type="checkbox"/> No Weight <b>#200</b> lbs./ft.				
2			Type and color of material		From	To	
			top Soil		0	5	
			Clay (Gray-White)		5	15	
			Sandy Clay		15	30	
			Fine Sand		30	34	
			Blue Shale		34	60	
			White Lime		60	70	
			Blue Shale		70	90	
			Lime (white)		90	105	
			Hard Blue Shale		105	110	
			white Lime		110	115	
			32' to 40' Cemented				
			10' to 32' Sand Grouted to				
			Seal off Sand water				
			which was undesirable.				
			(use a second sheet if needed)				
16 Remarks: elevation well is: 2 miles north of Hackney, 12 FT south of north line + 60 FT west of East line. Fresh water vein 48 FT			17 Water well contractor's certification: This well was drilled under my jurisdiction and this report is true to the best of my knowledge and belief. <b>Ronal Heffron Drilling #113</b> Business name _____ License No. _____ Address <b>Route 3, Winfield, Kans. 67156</b> Signed <b>Ronal Heffron</b> Date <b>11-28-75</b> Authorized representative				

33  
4E  
7  
NE  
NE  
NE  
NE