


1 LOCATION OF WATER WELL: Fraction NW 1/4 SW 1/4 SE 1/4 Section Number 9 Township Number T 33 S Range Number R 4-E EW

Distance and direction from nearest town or city street address of well if located within city?

1 3/4 S outh Winfield on County 27

2 WATER WELL OWNER: Marion May RFD # 3 RR#, St. Address, Box #: Winfield, Kansas 67156 City, State, ZIP Code: Board of Agriculture, Division of Water Resources Application Number:

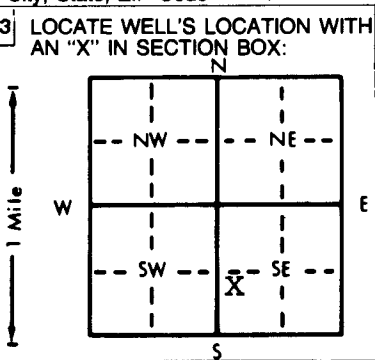

4 DEPTH OF COMPLETED WELL: 80 ft. ELEVATION: Unk. Depth(s) Groundwater Encountered 1. 60 ft. 2. ft. 3. ft. WELL'S STATIC WATER LEVEL: 28.5 ft. below land surface measured on mo/day/yr 10-17-88 Pump test data: Well water was 28.5 ft. after 4 hours pumping 15 gpm Est. Yield: 50/60 gpm: Well water was ft. after hours pumping gpm Bore Hole Diameter: 8 in. to T.D. ft., and in. to ft. WELL WATER TO BE USED AS: 5 Public water supply 8 Air conditioning 11 Injection well (1 Domestic) 3 Feedlot 6 Oil field water supply 9 Dewatering 12 Other (Specify below) 2 Irrigation 4 Industrial 7 Lawn and garden only 10 Observation well Was a chemical/bacteriological sample submitted to Department? Yes No X; If yes, mo/day/yr sample was submitted Water Well Disinfected? Yes X No

5 TYPE OF BLANK CASING USED: 1 Steel 3 RMP (SR) 5 Wrought iron 8 Concrete tile CASING JOINTS: Glued X Clamped 2 Brass 4 Galvanized steel 6 Asbestos-Cement 9 Other (specify below) Welded 7 Fiberglass Threaded 8 PVC 4 ABS 7 Fiberglass Threaded Blank casing diameter: 5 in. to 70 ft., Dia. in. to ft., Dia. in. to ft. Casing height above land surface: 24 in., weight: 160# lbs./ft. Wall thickness or gauge No. SDR 26. TYPE OF SCREEN OR PERFORATION MATERIAL: (7 PVC) 10 Asbestos-cement 1 Steel 3 Stainless steel 5 Fiberglass 8 RMP (SR) 11 Other (specify) 2 Brass 4 Galvanized steel 6 Concrete tile 9 ABS 12 None used (open hole) SCREEN OR PERFORATION OPENINGS ARE: 5 Gauzed wrapped 8 Saw cut 11 None (open hole) 1 Continuous slot (3 Mill slot) 6 Wire wrapped 9 Drilled holes 2 Louvered shutter 4 Key punched 7 Torch cut 10 Other (specify) SCREEN-PERFORATED INTERVALS: From 70 ft. to 80 ft., From ft. to ft. GRAVEL PACK INTERVALS: From 25 ft. to T.D. ft., From ft. to ft.

6 GROUT MATERIAL: (1 Neat cement) 2 Cement grout 3 Bentonite 4 Other Grout Intervals: From ft. to ft., From ft. to ft., From ft. to ft. What is the nearest source of possible contamination: 1 Septic tank (4 Lateral lines) 7 Pit privy 10 Livestock pens 14 Abandoned water well 2 Sewer lines 5 Cess pool 8 Sewage lagoon 11 Fuel storage 15 Oil well/Gas well 3 Watertight sewer lines 6 Seepage pit 9 Feedyard 12 Fertilizer storage 16 Other (specify below) 13 Insecticide storage Direction from well? South How many feet? 85

FROM	TO	LITHOLOGIC LOG	FROM	TO	LITHOLOGIC LOG
0	3	Soil			
3	25	Wht. lm	12 ft.		Lost Circ. @ 12 ft.
25	45	Sh/ lm shells			
45	50	lm. hrd drk gry			
50	60	Bkn. lm rough drlg (water zone)			
60	65	Hrd lm			
65	70	Multi color sh (water)			
70	80	Blu lm / sh			
80	T.D.				

7 CONTRACTOR'S OR LANDOWNER'S CERTIFICATION: This water well was (1) constructed, (2) reconstructed, or (3) plugged under my jurisdiction and was completed on (mo/day/year) 10-14-88 and this record is true to the best of my knowledge and belief. Kansas Water Well Contractor's License No. 171 This Water Well Record was completed on (mo/day/yr) 10-28-88 under the business name of G & S Drilling by (signature) [Signature]

INSTRUCTIONS: Use typewriter or ball point pen. PLEASE PRESS FIRMLY and PRINT clearly. Please fill in blanks, underline or circle the correct answers. Send top filed copies to Kansas Department of Health and Environment, Bureau of Water Protection, Topeka, Kansas 66620-7320, Telephone: 913-862-9300. Send one to WATER WELL OWNER and retain one for your records.

OFFICE USE ONLY T R EW SEC.