USE TYPEWRITER OR BALL POINT PEN-PRESS FIRMLY, PRINT CLEARLY.

WATER WELL RECORD
KSA 82a-1201-1215

Kansas Department of Health and Environment-Division of Environment
(Water well Contractors)
Topeka, Kansas 66620

1. Location of well:	County	Fraction	Section number	Township number	Range number
	Cowley	NW 1/4 SW 1/4 NE 1/4	14	T 33 S	R 4 E/W

2. Distance and direction from nearest town or city: 3 miles south of Winfield on #27, 1½ East, 1/4 south, East 1/2.
Street address of well location if in city:

3. Owner of well: Barton McCollum
R.R. or street: Route 3
City, state, zip code: Winfield, Kansas 67156

4. Locate with "X" in section below:

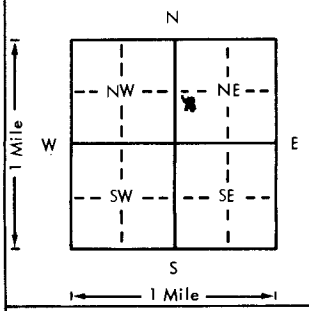

Sketch map: River

6. Bore hole dia. 12 in. Completion date 11-10-80
Well depth 46 ft.

7. X Cable tool __ Rotary __ Driven __ Dug
__ Hollow rod __ Jetted __ Bored __ Reverse rotary

8. Use: X Domestic __ Public supply __ Industry
__ Irrigation __ Air conditioning __ Stock
__ Lawn __ Oil field water __ Other

9. Casing: Material _____ Height: Above or below
Threaded ____ Welded ____ Surface 6 ft. in.
RMP ____ PVC X Weight 2.83 lbs./ft.
Dia. 5 in. to 46 ft. depth Wall Thickness: inches or
Dia. ____ in. to ____ ft. depth gage No. .258

5. Type and color of material	From	To
Top Soil	0	5
Black Soil	5	25
Gray Soil	25	39
Gravel (Water)	39	41
Red Bed	41	45
Lime	45	46
(Use a second sheet if needed)		

10. Screen: Manufacturer's name Pumpco (Lay Length)
Type PVC Dia. 5"
Slot/gauze Slot Length 10'
Set between 36' ft. and 46 ft.
____ ft. and ____ ft.
Gravel pack? X Size range of material 1/2

11. Static water level: mo./day/yr.
35 ft. below land surface Date 11-10-80

12. Pumping level below land surfaces:
____ ft. after ____ hrs. pumping ____ g.p.m.
____ ft. after ____ hrs. pumping ____ g.p.m.
Estimated maximum yield 12 g.p.m. Bailer Test

13. Water sample submitted: mo./day/yr.
__ Yes X No Date ____

14. Well head completion: above ground level
__ Pitless adapter 6 ft. Inches above grade

15. Well grouted? yes
With: X Neat cement ____ Bentonite ____ Concrete
Depth: From 0 ft. to 12 ft.

16. Nearest source of possible contamination:
ft. 100 Direction north Type septic tank line
Well disinfected upon completion? X Yes ____ No

17. Pump: X Not installed
Manufacturer's name ____
Model number ____ HP ____ Volts ____
Length of drop pipe ____ ft. capacity ____ g.p.m.
Type:
__ Submersible __ Turbine
__ Jet __ Reciprocating
__ Centrifugal __ Other

18. Elevation:

Tapography:
__ Hill
__ Slope
__ Upland
X Valley

19. Remarks:
XXXXXXXX

20. Water well contractor's certification:
This well was drilled under my jurisdiction and this report is true to the best of my knowledge and belief.
Ronal Heffron Drilling 113
Business name License No.
Address Rt. 3 Winfield, Kans. 67156
Signed Ronal Heffron Date 12-2-80
Authorized representative

T 33 S R 4 E/W Sec 14 1/4 NW SW NE 1/4

Forward the white, blue and pink copies to the Department of Health and Environment

Form WWC-5

MI-1023