


1 LOCATION OF WATER WELL: County: **COWLEY** Fraction: **NE 1/4 SE 1/4 SE 1/4** Section Number: **19** Township Number: **T 33 S** Range Number: **R 4 EW**
 Distance and direction from nearest town or city street address of well if located within city?

2 WATER WELL OWNER: **Smoother Field Industrial Park** Board of Agriculture, Division of Water Resources
 RR#, St. Address, Box # : **MONITOR WELL # 1** Application Number:
 City, State, ZIP Code :

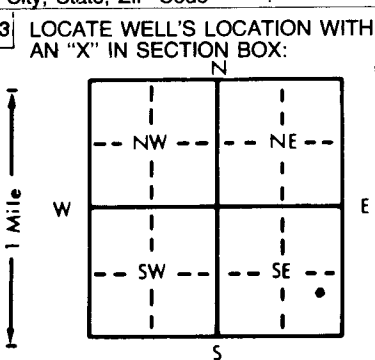

4 DEPTH OF COMPLETED WELL: **37.5'** ft. ELEVATION:
 Depth(s) Groundwater Encountered 1. **18.0'** ft. 2. ft. 3. ft.
 WELL'S STATIC WATER LEVEL **18.0'** ft. below land surface measured on mo/day/yr **9-22-83**
 Pump test data: Well water was ft. after hours pumping gpm
 Est. Yield gpm: Well water was ft. after hours pumping gpm
 Bore Hole Diameter in. to ft., and in. to ft.
 WELL WATER TO BE USED AS: 5 Public water supply 8 Air conditioning 11 Injection well
 1 Domestic 3 Feedlot 6 Oil field water supply 9 Dewatering 12 Other (Specify below)
 2 Irrigation 4 Industrial 7 Lawn and garden only **10 Observation well**
 Was a chemical/bacteriological sample submitted to Department? Yes No If yes, mo/day/yr sample was submitted
 Water Well Disinfected? Yes No

5 TYPE OF BLANK CASING USED: 1 Steel 3 RMP (SR) 5 Wrought iron 8 Concrete tile CASING JOINTS: Glued Clamped
2 PVC 4 ABS 7 Fiberglass 9 Other (specify below) Welded
 Blank casing diameter **4** in. to ft., Dia. in. to ft., Dia. in. to ft.
 Casing height above land surface **91 ft.** weight lbs./ft. Wall thickness or gauge No. **SCHEDULE 40**
 TYPE OF SCREEN OR PERFORATION MATERIAL: **7 PVC** 10 Asbestos-cement
 1 Steel 3 Stainless steel 5 Fiberglass 8 RMP (SR) 11 Other (specify)
 2 Brass 4 Galvanized steel 6 Concrete tile 9 ABS 12 None used (open hole)
 SCREEN OR PERFORATION OPENINGS ARE: 5 Gauzed wrapped **8 Saw cut** 11 None (open hole)
 1 Continuous slot 3 Mill slot 6 Wire wrapped 9 Drilled holes
 2 Louvered shutter 4 Key punched 7 Torch cut 10 Other (specify)
 SCREEN-PERFORATED INTERVALS: From **27'** ft. to **37'** ft., From ft. to ft.
 GRAVEL PACK INTERVALS: From ft. to ft., From ft. to ft.

6 GROUT MATERIAL: 1 Neat cement 2 Cement grout **3 Bentonite** 4 Other
 Grout Intervals: From **10** ft. to **11** ft., From ft. to ft., From ft. to ft.
 What is the nearest source of possible contamination:
 1 Septic tank 4 Lateral lines 7 Pit privy 10 Livestock pens 14 Abandoned water well
 2 Sewer lines 5 Cess pool 8 Sewage lagoon 11 Fuel storage 15 Oil well/Gas well
 3 Watertight sewer lines 6 Seepage pit 9 Feedyard 12 Fertilizer storage 16 Other (specify below)
 Direction from well? **Aerial groundwater contamination**
 How many feet?

| FROM | TO | LITHOLOGIC LOG | FROM | TO | LITHOLOGIC LOG |
|------|----|-----------------------------|------|----|----------------|
| 0 | 24 | LT BROWN SANDY/SILTY CLAY | | | |
| 24 | 26 | BR FINE SAND: SILTY SAND | | | |
| 26 | 42 | BR FINE-COARSE ARKOSIC SAND | | | |
| 42 | | SHALE | | | |

7 CONTRACTOR'S OR LANDOWNER'S CERTIFICATION: This water well was **1** constructed, **2** reconstructed, or **3** plugged under my jurisdiction and was completed on (mo/day/year) **9-12-83** and this record is true to the best of my knowledge and belief. Kansas Water Well Contractor's License No. **249** This Water Well Record was completed on (mo/day/yr) **3-28-84** under the business name of **HUNT DRILLING Co** by (signature) **Walter A Hunt**

INSTRUCTIONS: Use typewriter or ball point pen, PLEASE PRESS FIRMLY and PRINT clearly. Please fill in blanks, underline or circle the correct answers. Send top three copies to Kansas Department of Health and Environment, Division of Environment, Environmental Geology Section, Topeka, KS 66620. Send one to WATER WELL OWNER and retain one for your records.

OFFICE USE ONLY

