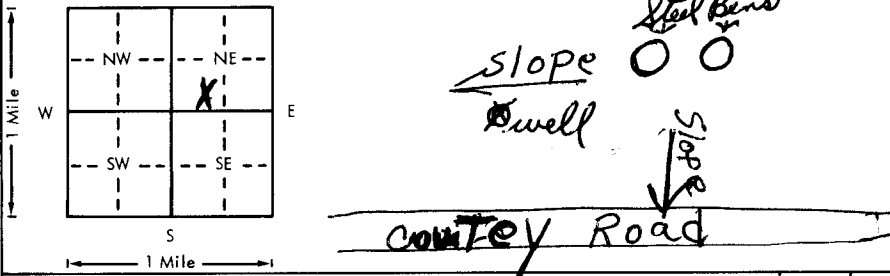


USE TYPEWRITER OR BALL
POINT PEN-PRESS FIRMLY,
PRINT CLEARLY.

WATER WELL RECORD
KSA 820-1201-1215

Kansas Department of Health and
Environment-Division of Environment
(Water well Contractors)
Topeka, Kansas 66620

1. Location of well:	County Cowley	Fraction SE 1/4 SW 1/4 NE 1/4	Section number 19	Township number T 33 S	Range number R 5 E
2. Distance and direction from nearest town or city: 4 mi So & 4 1/4 mi East of Winfield, Kansas Street address of well location if in city:			3. Owner of well: Helen Seacat R.R. or street: 1201 E. 10th City, state, zip code: Winfield, Kansas 67156		
4. Locate with "X" in section below: N 1 Mile W E S 1 Mile			Sketch map: 		
5. Type and color of material			From	To	6. Bore hole dia. 10 in. Completion date 12/6/78 Well depth 128 ft.
Lime and Lime Shale			0	15	7. <input checked="" type="checkbox"/> Cable tool <input type="checkbox"/> Rotary <input type="checkbox"/> Driven <input type="checkbox"/> Dug <input type="checkbox"/> Hollow rod <input type="checkbox"/> Jetted <input type="checkbox"/> Bored <input type="checkbox"/> Reverse rotary
Blue Shale			15	105	8. Use: <input type="checkbox"/> Domestic <input type="checkbox"/> Public supply <input type="checkbox"/> Industry <input type="checkbox"/> Irrigation <input type="checkbox"/> Air conditioning <input checked="" type="checkbox"/> Stock <input type="checkbox"/> Lawn <input type="checkbox"/> Oil field water <input type="checkbox"/> Other
Lime			105	110	9. Casing: Material plastic Height: (24) Above or below Threaded <input type="checkbox"/> Welded <input type="checkbox"/> Surface 24 in. RMP <input type="checkbox"/> PVC <input checked="" type="checkbox"/> Weight <input type="checkbox"/> lbs./ft. Dia. 5 in. to 128 ft. depth Wall Thickness: inches or Dia. <input type="checkbox"/> in. to <input type="checkbox"/> ft. depth gage No. Schedule 40
Blue Shale			110	115	10. Screen: Manufacturer's name unknown Type PVX Dia. 5" <input checked="" type="checkbox"/> Slot gauge 1/16th Length 10 ft. Set between 118 ft. and 128 ft. <input type="checkbox"/> ft. and <input type="checkbox"/> ft. Gravel pack? yes Size range of material 5/8"
Red Bed			115	120	11. Static water level: 32 ft. below land surface Date 12/6/78 mo./day/yr.
Lime			120	128	12. Pumping level below land surfaces: bailer test <input type="checkbox"/> ft. after <input type="checkbox"/> hrs. pumping <input type="checkbox"/> g.p.m. <input type="checkbox"/> ft. after <input type="checkbox"/> hrs. pumping <input type="checkbox"/> g.p.m. Estimated maximum yield 2 g.p.m.
					13. Water sample submitted: <input type="checkbox"/> Yes <input checked="" type="checkbox"/> No Date <input type="checkbox"/> mo./day/yr.
					14. Well head completion: <input type="checkbox"/> Pitless adapter 24 Inches above grade
					15. Well grouted? yes With: <input checked="" type="checkbox"/> Neat cement <input type="checkbox"/> Bentonite <input type="checkbox"/> Concrete Depth: From 33 ft. to 0 ft.
					16. Nearest source of possible contamination: in cattle lot ft. <input type="checkbox"/> Direction <input type="checkbox"/> Type <input type="checkbox"/> Well disinfected upon completion? <input checked="" type="checkbox"/> Yes <input type="checkbox"/> No
					17. Pump: <input checked="" type="checkbox"/> Not installed Manufacturer's name <input type="checkbox"/> Model number <input type="checkbox"/> HP <input type="checkbox"/> Volts <input type="checkbox"/> Length of drop pipe <input type="checkbox"/> ft. capacity <input type="checkbox"/> g.p.m. Type: <input type="checkbox"/> Submersible <input type="checkbox"/> Turbine <input type="checkbox"/> Jet <input type="checkbox"/> Reciprocating <input type="checkbox"/> Centrifugal <input type="checkbox"/> Other
(Use a second sheet if needed)					
18. Elevation: Topography: <input type="checkbox"/> Hill <input checked="" type="checkbox"/> Slope <input type="checkbox"/> Upland <input type="checkbox"/> Valley	19. Remarks: Helen Seacat Concrete Slab to be installed by customer at surface of ground. She knows this is a regulation		20. Water well contractor's certification: This well was drilled under my jurisdiction and this report is true to the best of my knowledge and belief. Ronal Heffron Drilling #113 Business name Route 3 License No. <input type="checkbox"/> Address Winfield, Kansas 67156 Signed Ronal Heffron Date 12-7 Authorized representative		

Forward the white, blue and pink copies to the Department of Health and Environment

Form WWC-5