


1 LOCATION OF WATER WELL: County: Cowley Fraction: NW 1/4 NE 1/4 NE 1/4 Section Number: 32 Township Number: T 33 S Range Number: R 5 E
 Distance and direction from nearest town or city street address of well if located within city? 4-E 8 1/2 S of Wind Field Kan

2 WATER WELL OWNER: Brad Metlinger 67156
 RR#, St. Address, Box #: 901 E 10 Wind Field Kan
 City, State, ZIP Code: 901 E 10 Wind Field Kan
 Board of Agriculture, Division of Water Resources
 Application Number:

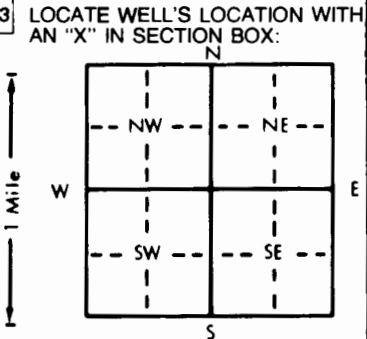

4 DEPTH OF COMPLETED WELL: 147 ft. ELEVATION: ft.
 Depth(s) Groundwater Encountered: 1. 70 ft. 2. ft. 3. ft.
 WELL'S STATIC WATER LEVEL: 20 ft. below land surface measured on mo/day/yr
 Pump test data: Well water was ft. after hours pumping gpm
 Est. Yield: 5 gpm. Well water was ft. after hours pumping gpm
 Bore Hole Diameter: 9 1/2 in. to ft. and in. to ft.
 WELL WATER TO BE USED AS:
 1 Domestic 3 Feedlot 6 Oil field water supply 9 Dewatering 12 Other (Specify below)
 2 Irrigation 4 Industrial 7 Lawn and garden only 10 Monitoring well
 Was a chemical/bacteriological sample submitted to Department? Yes..... No X..... If yes, mo/day/yr sample was submitted
 Water Well Disinfected? Yes X No

5 TYPE OF BLANK CASING USED:
 1 Steel 3 RMP (SR) 6 Asbestos-Cement 9 Other (specify below) CASING JOINTS: Glued X Clamped
 2 PVC 4 ABS 7 Fiberglass Threaded.....
 Blank casing diameter: 5 in. to 60 ft. Dia. in. to ft. Dia. in. to ft.
 Casing height above land surface: 18 in., weight: 160 lbs./ft. Wall thickness or gauge No. 124
 TYPE OF SCREEN OR PERFORATION MATERIAL:
 1 Steel 3 Stainless steel 5 Fiberglass 8 RMP (SR) 11 Other (specify)
 2 Brass 4 Galvanized steel 6 Concrete tile 9 ABS 12 None used (open hole)
 SCREEN OR PERFORATION OPENINGS ARE:
 1 Continuous slot 3 Mill slot 5 Gauzed wrapped 8 Saw cut 11 None (open hole)
 2 Louvered shutter 4 Key punched 6 Wire wrapped 9 Drilled holes
 7 Torch cut 10 Other (specify)
 SCREEN-PERFORATED INTERVALS: From 60 ft. to 147 ft. From ft. to ft.
 GRAVEL PACK INTERVALS: From ft. to ft. From ft. to ft.

6 GROUT MATERIAL: 1 Neat cement 2 Cement grout 3 Bentonite 4 Other
 Grout Intervals: From 3 ft. to 23 ft. From ft. to ft. From ft. to ft.
 What is the nearest source of possible contamination:
 1 Septic tank 4 Lateral lines 7 Pit privy 10 Livestock pens 14 Abandoned water well
 2 Sewer lines 5 Cess pool 8 Sewage lagoon 11 Fuel storage 15 Oil well/Gas well
 3 Watertight sewer lines 6 Seepage pit 9 Feedyard 12 Fertilizer storage 16 Other (specify below)
 13 Insecticide storage
 Direction from well? NW How many feet? 250

FROM	TO	LITHOLOGIC LOG	FROM	TO	PLUGGING INTERVALS
0	3	Soil			
3	8	Rock			
8	25	Clay			
25	147	Shale & Lime			

7 CONTRACTOR'S OR LANDOWNER'S CERTIFICATION: This water well was X constructed, (2) reconstructed, or (3) plugged under my jurisdiction and was completed on (mo/day/year) 3/24/98 and this record is true to the best of my knowledge and belief. Kansas Water Well Contractor's License No. 257 This Water Well Record was completed on (mo/day/year) 4/13/98 under the business name of Winter Well Drills by (signature) Charles Winters

OFFICE USE ONLY
T
R
EW
SEC.
1/4
1/4
1/4