

CORRECTION(S) TO WATER WELL RECORD (WWC-5)
(to rectify lacking or incorrect information)

Location listed as:

Section-Township-Range: 5-33S-5

Fraction ($\frac{1}{4}$ $\frac{1}{4}$ $\frac{1}{4}$): None Given

County: Cowley
Location changed to:

6-33S-5E

SW SW NW

Other changes: Initial statements: _____

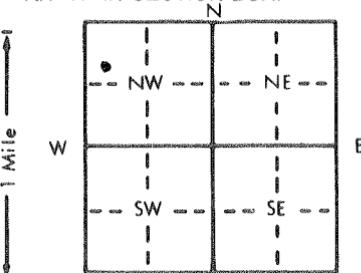
Changed to: _____

Comments: well owner's address: 13105 186th Dr., Winfield, KS
67156.

verification method: Cowley County online parcel search, and
mapping tool & aerial photos on KGS website.

initials: DR date: 7/13/2012

submitted by: Kansas Geological Survey, Data Resources Library, 1930 Constant Ave., Lawrence, KS 66047-3726
to: Kansas Dept of Health & Environment, Bureau of Water, 1000 SW Jackson, Suite 420, Topeka, KS 66612-1367.

1 LOCATION OF WATER WELL: County: <u>Cowley</u>		Fraction <u>1/4</u>	Fraction <u>1/4</u>	Fraction <u>1/4</u>	Section Number <u>5</u>	Township Number <u>T 33 S</u>	Range Number <u>R 5 E/W</u>
Distance and direction from nearest town or city street address of well if located within city? <u>Rt.#5, Box 69C Winfield, KS 67156</u>							
2 WATER WELL OWNER: RR#, St. Address, Box # : City, State, ZIP Code :		Kevin Potts <u>Rt.#5, Box 69C</u> <u>Winfield, KS 67156</u>			Board of Agriculture, Division of Water Resources Application Number:		
3 LOCATE WELL'S LOCATION WITH AN "X" IN SECTION BOX:		4 DEPTH OF COMPLETED WELL..... <u>120</u> ft. ELEVATION:					
		Depth(s) Groundwater Encountered 1. ft. 2. ft. 3. ft.					
		WELL'S STATIC WATER LEVEL <u>25</u> ft. below land surface measured on mo/day/yr <u>6/5/98</u>					
		Pump test data: Well water was ft. after hours pumping gpm					
		Est. Yield gpm: Well water was ft. after hours pumping gpm					
		Bore Hole Diameter..... <u>9</u> .in. to <u>120</u> ft., andin. to ft.					
		WELL WATER TO BE USED AS: 5 Public water supply 8 Air conditioning 11 Injection well					
		1 Domestic 3 Feedlot 6 Oil field water supply 9 Dewatering 12 Other (Specify below)					
		2 Irrigation 4 Industrial <u>7</u> Lawn and garden only 10 Monitoring well					
		Was a chemical/bacteriological sample submitted to Department? Yes.....No..... <u>X</u> ; If yes, mo/day/yr sample was submitted					
		Water Well Disinfected? Yes <u>X</u> No					
5 TYPE OF BLANK CASING USED:		CASING JOINTS: Glued <u>X</u> Clamped					
1 Steel 3 RMP (SR)		5 Wrought iron 8 Concrete tile					
<u>2</u> PVC 4 ABS		6 Asbestos-Cement 9 Other (specify below) Welded					
		7 Fiberglass Threaded					
Blank casing diameter <u>5</u> in. to ft., Dia in. to ft., Dia in. to ft.							
Casing height above land surface <u>15</u> in., weight lbs./ft. Wall thickness or gauge No.							
TYPE OF SCREEN OR PERFORATION MATERIAL:		<u>7</u> PVC 10 Asbestos-cement					
1 Steel 3 Stainless steel 5 Fiberglass 8 RMP (SR)		11 Other (specify)					
2 Brass 4 Galvanized steel 6 Concrete tile 9 ABS		12 None used (open hole)					
SCREEN OR PERFORATION OPENINGS ARE:		5 Gauzed wrapped <u>8</u> Saw cut 11 None (open hole)					
1 Continuous slot 3 Mill slot 6 Wire wrapped 9 Drilled holes							
2 Louvered shutter 4 Key punched 7 Torch cut 10 Other (specify)							
SCREEN-PERFORATED INTERVALS: From <u>78</u> ft. to <u>118</u> ft., From ft. to ft.							
		From ft. to ft., From ft. to ft.					
GRAVEL PACK INTERVALS: From <u>20</u> ft. to <u>120</u> ft., From ft. to ft.							
		From ft. to ft., From ft. to ft.					
6 GROUT MATERIAL: 1 Neat cement 2 Cement grout <u>3</u> Bentonite 4 Other							
Grout Intervals: From <u>4</u> ft. to <u>20</u> ft., From ft. to ft., From ft. to ft.							
What is the nearest source of possible contamination:		10 Livestock pens 14 Abandoned water well					
1 Septic tank 4 Lateral lines 7 Pit privy 11 Fuel storage 15 Oil well/Gas well							
2 Sewer lines 5 Cess pool 8 Sewage lagoon 12 Fertilizer storage 16 Other (specify below)							
3 Watertight sewer lines 6 Seepage pit 9 Feedyard 13 Insecticide storage							
Direction from well?		How many feet?					
FROM	TO	LITHOLOGIC LOG	FROM	TO	PLUGGING INTERVALS		
0	8	Soil					
8	90	Limestone					
90	105	Shale					
105	110	Limestone					
110	120	Shale					
7 CONTRACTOR'S OR LANDOWNER'S CERTIFICATION: This water well was <u>(1)</u> constructed, (2) reconstructed, or (3) plugged under my jurisdiction and was completed on (mo/day/year) <u>6/6/98</u> and this record is true to the best of my knowledge and belief. Kansas Water Well Contractor's License No. <u>171</u> This Water Well Record was completed on (mo/day/yr) <u>6/9/98</u> under the business name of <u>G & S Drilling, Inc.</u> by (signature) <u>Timothy E. Brandt</u>							
INSTRUCTIONS: Use typewriter or ball point pen. PLEASE PRESS FIRMLY and PRINT clearly. Please fill in blanks, underline or circle the correct answers and send top three copies to Kansas Department of Health and Environment, Bureau of Water, Topeka, Kansas 66620-0001. Telephone: 913-296-5545. Send one to WATER WELL OWNER and retain one for your records.							