USE TYPEWRITER OR BALL POINT PEN-PRESS FIRMLY, PRINT CLEARLY.

WATER WELL RECORD
KSA 82a-1201-1215

Kansas Department of Health and Environment-Division of Environment
(Water well Contractors)
Topeka, Kansas 66620

1. Location of well:	County	Fraction	Section number	Township number	Range number
	Cowley	SW 1/4 SW 1/4 SW 1/4	17	T 33 (S)	R 6 (E/W)

2. Distance and direction from nearest town or city: 5 w - Dexter

Street address of well location if in city:

3. Owner of well: Willard Wise
R.R. or street: RR # 1
City, state, zip code: Dexter Kans 67038

4. Locate with "X" in section below:

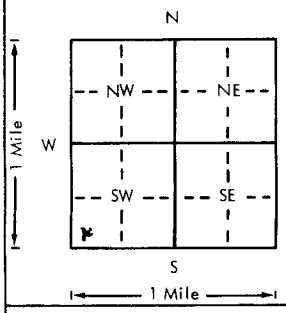

Sketch map:

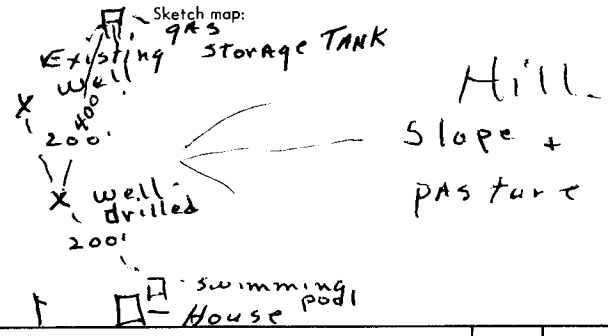

6. Bore hole dia. 8 in. Completion date 9-8-78
Well depth 100 ft.

7. X Cable tool __ Rotary __ Driven __ Dug
__ Hollow rod __ Jetted __ Bored __ Reverse rotary

8. Use: __ Domestic __ Public supply __ Industry
X Irrigation __ Air conditioning __ Stock
X Lawn __ Oil field water __ Other

9. Casing: Material _____ Height: Above or below
Threaded ____ Welded ____ Surface 12 in.
RMP ____ PVC X Weight 200 lbs./ft.
Dia. 6 in. to 12 ft. depth Wall Thickness: inches or
Dia. ____ in. to ____ ft. depth gage No. 3/8"

10. Screen: Manufacturer's name NONE
Type _____ Dia. _____
Slot/gauze _____ Length _____
Set between _____ ft. and _____ ft.
_____ ft. and _____ ft.
Gravel pack? ____ Size range of material _____

11. Static water level: mo./day/yr.
8 ft. below land surface Date 9-8-78

12. Pumping level below land surfaces:
____ ft. after ____ hrs. pumping ____ g.p.m.
____ ft. after ____ hrs. pumping ____ g.p.m.
Estimated maximum yield 40 g.p.H.

13. Water sample submitted: mo./day/yr.
__ Yes X No Date _____

14. Well head completion:
__ Pitless adapter 12 Inches above grade

15. Well grouted? ____
With: X Neat cement ____ Bentonite ____ Cancrete
Depth: From - ft. to 12 ft.

16. Nearest source of possible contamination:
ft. 400 Direction N Type gas Storage
Well disinfected upon completion? X Yes ____ No

17. Pump: X Not installed
Manufacturer's name _____
Model number _____ HP _____ Volts _____
Length of drop pipe _____ ft. capacity _____ g.p.m.
Type:
__ Submersible __ Turbine
__ Jet __ Reciprocating
__ Centrifugal __ Other

5. Type and color of material	From	To
Soil (black)	-	2
Shale (grey)	2	4
Lime (grey)	4	74
Shale (grey)	74	84
Red Rock	84	96
Lime grey	96	100
TD - 100'		
Water was picked up in		
formation at 28' to 40'.		
(Use a second sheet if needed)		

18. Elevation:

Topography:
__ Hill
__ Slope
X Upland
__ Valley

19. Remarks:
Owner will run curb. + make completion of well requirements.

20. Water well contractor's certification:
This well was drilled under my jurisdiction and this report is true to the best of my knowledge and belief.
Business name Bailey Drilling Co. License No. 209
Address Box 192 Burden, Kans. 67019
Signed Donald E Bailey Date 9-26-78
Authorized representative

T 33 R 6 (E/W) Sec 17 1/4 SW SW SW

Forward the white, blue and pink copies to the Department of Health and Environment

Form WWC-5

M1-1023