


1 LOCATION OF WATER WELL: Fraction NE 1/4 NE 1/4 NW 1/4 Section Number 3 Township Number T 34 S Range Number R 11 E/W

Distance and direction from nearest town or city street address of well if located within city? One stop 301 W. Main Sedan, KS

2 WATER WELL OWNER: Neal & Mike Felto RR#, St. Address, Box #: 301 W. Main City, State, ZIP Code: Sedan KS 67361 Board of Agriculture, Division of Water Resources Application Number:

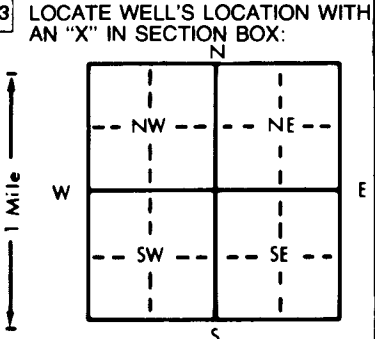

3 LOCATE WELL'S LOCATION WITH AN 'X' IN SECTION BOX: 4 DEPTH OF COMPLETED WELL: 30 ft. ELEVATION: Depth(s) Groundwater Encountered: 1. 23.13 ft. 2. 3. WELL'S STATIC WATER LEVEL: 23.13 ft. below land surface measured on mo/day/yr 12-1-95

5 TYPE OF BLANK CASING USED: 1 Steel 2 PVC 3 RMP (SR) 4 ABS 5 Wrought iron 6 Asbestos-Cement 7 Fiberglass 8 Concrete tile 9 Other (specify below) 10 Asbestos-cement CASING JOINTS: Glued Clamped Welded Threaded X

6 GROUT MATERIAL: 1 Neat cement 2 Cement grout 3 Bentonite 4 Other Grout Intervals: From 13.5 ft. to 5 ft. From 5 ft. to 0 ft. From 5 ft. to 0 ft. From 0 ft. to 0 ft. From 0 ft. to 0 ft.

Table with columns: FROM, TO, LITHOLOGIC LOG, FROM, TO, PLUGGING INTERVALS. Row 1: FROM, TO, LITHOLOGIC LOG, FROM 2.0, TO 30.0, PLUGGING INTERVALS Bentonite

7 CONTRACTOR'S OR LANDOWNER'S CERTIFICATION: This water well was (1) constructed, (2) reconstructed, or (3) plugged under my jurisdiction and was completed on (mo/day/year) 12-1-95 and this record is true to the best of my knowledge and belief. Kansas Water Well Contractor's License No. 531 This Water Well Record was completed on (mo/day/yr) 12-5-95 under the business name of GSI by (signature) Allison M. Jovan

OFFICE USE ONLY T R E/W SEC. 1/4 1/4 1/4