


1 LOCATION OF WATER WELL: County: Chautauqua Fraction: NW 1/4 NW 1/4 NE 1/4 Section Number: 3 Township Number: T 34 S Range Number: R 11 EW

Distance and direction from nearest town or city street address of well if located within city?
221 W. Main, Sedan, Ks.

2 WATER WELL OWNER: Richard Blake
 RR#, St. Address, Box #: P.O. Drawer J
 City, State, ZIP Code: Sedan, Ks. 67361
 Board of Agriculture, Division of Water Resources
 Application Number:

3 LOCATE WELL'S LOCATION WITH AN "X" IN SECTION BOX:

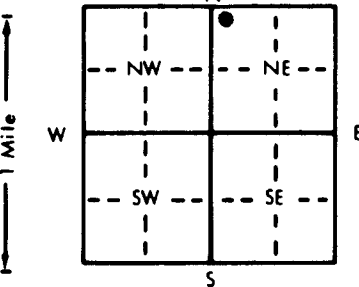

4 DEPTH OF COMPLETED WELL: 30' ft. ELEVATION:
 Depth(s) Groundwater Encountered 1. 25' ft. 2. ft. 3. ft.
 WELL'S STATIC WATER LEVEL: 24' 8" ft. below land surface measured on mo/day/yr 4-5-94
 Pump test data: Well water was ft. after hours pumping gpm
 Est. Yield gpm: Well water was ft. after hours pumping gpm
 Bore Hole Diameter: 8 1/2" in. to 30" ft., and in. to ft.
 WELL WATER TO BE USED AS:
 5 Public water supply 8 Air conditioning 11 Injection well
 1 Domestic 3 Feedlot 6 Oil field water supply 9 Dewatering 12 Other (Specify below)
 2 Irrigation 4 Industrial 7 Lawn and garden only 10 Monitoring well
 Was a chemical/bacteriological sample submitted to Department? Yes No X; If yes, mo/day/yr sample was submitted
 Water Well Disinfected? Yes No

5 TYPE OF BLANK CASING USED:
 1 Steel 3 RMP (SR) 5 Wrought iron 8 Concrete tile CASING JOINTS: Glued Clamped
2 PVC 4 ABS 6 Asbestos-Cement 9 Other (specify below) Welded
 7 Fiberglass Threaded X

Blank casing diameter 2.375 in. to 15' ft. Dia. in. to ft. Dia. in. to ft.
 Casing height above land surface Push Mount in., weight lbs./ft. Wall thickness or gauge No. SDR 13

TYPE OF SCREEN OR PERFORATION MATERIAL:
 1 Steel 3 Stainless steel 5 Fiberglass 8 RMP (SR) 10 Asbestos-cement SCH 40
 2 Brass 4 Galvanized steel 6 Concrete tile 9 ABS 11 Other (specify)
 12 None used (open hole)

SCREEN OR PERFORATION OPENINGS ARE:
 1 Continuous slot 3 Mill slot 5 Gauzed wrapped 8 Saw cut 11 None (open hole)
 2 Louvered shutter 4 Key punched 6 Wire wrapped 9 Drilled holes
 7 Torch cut 10 Other (specify)

SCREEN-PERFORATED INTERVALS: From 30' ft. to 15' ft. From ft. to ft.
 From ft. to ft. From ft. to ft.
 GRAVEL PACK INTERVALS: From 30' ft. to 13' ft. From ft. to ft.
 From ft. to ft. From ft. to ft.

6 GROUT MATERIAL: 1 Neat cement 3 Cement grout 5 Bentonite 4 Other
 Grout Intervals: From 13' ft. to 4' ft. From 4' ft. to 0' ft. From ft. to ft.

What is the nearest source of possible contamination:
 1 Septic tank 4 Lateral lines 7 Pit privy 10 Livestock pens 14 Abandoned water well
 2 Sewer lines 5 Cess pool 8 Sewage lagoon 11 Fuel storage Fuel 15 Oil well/Gas well
 3 Watertight sewer lines 6 Seepage pit 9 Feedyard 12 Fertilizer storage 16 Other (specify below)
 13 Insecticide storage
 Direction from well? West How many feet? 80'

FROM	TO	LITHOLOGIC LOG	FROM	TO	PLUGGING INTERVALS
0	3	Grass- dk brn silty clay w/ glass rubble, earthy odor.	brick,		
3	20	yellow to pale green sandstone, dry-med soft, slight to med. odor. Mod. odor at 20'			
20	30	dk gray- gray brn shale, very hard, no odor. Wet at 25'			

7 CONTRACTOR'S OR LANDOWNER'S CERTIFICATION: This water well was (1) constructed, (2) reconstructed, or (3) plugged under my jurisdiction and was completed on (mo/day/year) 4-5-94 and this record is true to the best of my knowledge and belief. Kansas Water Well Contractor's License No. 539. This Water Well Record was completed on (mo/day/yr) 4-16-94 under the business name of JB Environmental Drilling by (signature) James Beber

OFFICE USE ONLY
T
R
EM
SEC.