


1 LOCATION OF WATER WELL: County: Chautauqua Fraction: NE 1/4 NE 1/4 NW 1/4 Section Number: 3 Township Number: T 34 S Range Number: R 11 EW

Distance and direction from nearest town or city street address of well if located within city?
One Stop 301 W. Main, Sedan, Ks.

2 WATER WELL OWNER: Neal & Mike Felts
 RR#, St. Address, Box #: Sedan, Ks. Board of Agriculture, Division of Water Resources
 City, State, ZIP Code: 301 W. Main Application Number:

3 LOCATE WELL'S LOCATION WITH AN "X" IN SECTION BOX:

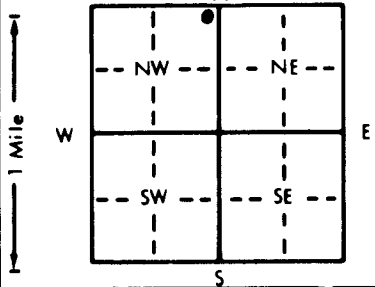

4 DEPTH OF COMPLETED WELL: 25' ft. ELEVATION:

Depth(s) Groundwater Encountered 1. 14' ft. 2. ft. 3. ft.
 WELL'S STATIC WATER LEVEL: 15.9' ft. below land surface measured on mo/day/yr 3-21-94
 Pump test data: Well water was ft. after hours pumping gpm
 Est. Yield gpm: Well water was ft. after hours pumping gpm
 Bore Hole Diameter: 8 1/2" in. to 25' ft., and in. to ft.
 WELL WATER TO BE USED AS:
 5 Public water supply 8 Air conditioning 11 Injection well
 1 Domestic 3 Feedlot 6 Oil field water supply 9 Dewatering 12 Other (Specify below)
 2 Irrigation 4 Industrial 7 Lawn and garden only 10 Monitoring well
 Was a chemical/bacteriological sample submitted to Department? Yes.....No X..... If yes, mo/day/yr sample was submitted
 Water Well Disinfected? Yes NO

5 TYPE OF BLANK CASING USED:
 1 Steel 3 RMP (SR) 5 Wrought iron 8 Concrete tile CASING JOINTS: Glued.....Clamped.....
2 PVC 4 ABS 6 Asbestos-Cement 9 Other (specify below) Welded.....
 7 Fiberglass Threaded..... X

Blank casing diameter 2.375 in. to 10' ft., Dia.....in. to.....ft., Dia.....in. to.....ft.
 Casing height above land surface Push Mount in., weight.....lbs./ft. Wall thickness or gauge No. SDR 13

TYPE OF SCREEN OR PERFORATION MATERIAL:
 1 Steel 3 Stainless steel 5 Fiberglass 8 RMP (SR) 11 Other (specify).....
 2 Brass 4 Galvanized steel 6 Concrete tile 9 ABS 12 None used (open hole)

SCREEN OR PERFORATION OPENINGS ARE:
 1 Continuous slot 3 Mill slot 5 Gauzed wrapped 8 Saw cut 11 None (open hole)
 2 Louvered shutter 4 Key punched 6 Wire wrapped 9 Drilled holes
 7 Torch cut 10 Other (specify).....

SCREEN-PERFORATED INTERVALS: From 25' ft. to 10' ft., From.....ft. to.....ft.
 From.....ft. to.....ft., From.....ft. to.....ft.
 GRAVEL PACK INTERVALS: From 25' ft. to 8' ft., From.....ft. to.....ft.
 From.....ft. to.....ft., From.....ft. to.....ft.

6 GROUT MATERIAL: 1 Neat cement 2 Cement grout 3 Bentonite 4 Other.....
 Grout Intervals: From 8' ft. to 4' ft., From 4' ft. to 0' ft., From.....ft. to.....ft.

What is the nearest source of possible contamination:
 1 Septic tank 4 Lateral lines 7 Pit privy 11 Fuel storage 14 Abandoned water well
 2 Sewer lines 5 Cess pool 8 Sewage lagoon 12 Fertilizer storage 15 Oil well/Gas well
 3 Watertight sewer lines 6 Seepage pit 9 Feedyard 13 Insecticide storage 16 Other (specify below)
 Direction from well? South East How many feet? 70'

FROM	TO	LITHOLOGIC LOG	FROM	TO	PLUGGING INTERVALS
0	2.50	Grass- Dk brn -yellow brn sandy clay/ broken sandstone gravel, moist, no odor, iron oxide staining.			
2.50	8.50	Yellow green sandstone, hard, moist, odor.			
8.50	25	yellow sandstone, hard, compact, no odor. interbedded sandstone, shale layers yellow-grayish sandstone, dry slight odor.			

7 CONTRACTOR'S OR LANDOWNER'S CERTIFICATION: This water well was (1) constructed (2) reconstructed, or (3) plugged under my jurisdiction and was completed on (mo/day/year) 3-21-94 and this record is true to the best of my knowledge and belief. Kansas Water Well Contractor's License No. 539. This Water Well Record was completed on (mo/day/yr) 3-31-94 under the business name of JB Environmental Drilling by (signature) James B. B...

INSTRUCTIONS: Use typewriter or ball point pen. PLEASE PRESS FIRMLY and PRINT clearly. Please fill in blanks, underline or circle the correct answers. Send top three copies to Kansas Department of Health and Environment, Bureau of Water, Topeka, Kansas 66620-0001. Telephone: 913-296-5545. Send one to WATER WELL OWNER and retain one for your records.

OFFICE USE ONLY