#2

WATER WELL RECORD Form WWC-5 KSA 82a-1212

1 LOCATION OF WATER WELL: County: Chautauqua | Fraction: NW ¼ NW ¼ NW ¼ | Section Number: 13 | Township Number: T 34 S | Range Number: R 11 E/W

Distance and direction from nearest town or city street address of well if located within city? 3 Miles S.E. of Sedan KS.

2 WATER WELL OWNER: William C. Gafford

RR#, St. Address, Box # : RR#1 Box 139

City, State, ZIP Code Sedan KS. 67361

Board of Agriculture, Division of Water Resources Application Number:

3 LOCATE WELL'S LOCATION WITH AN "X" IN SECTION BOX:

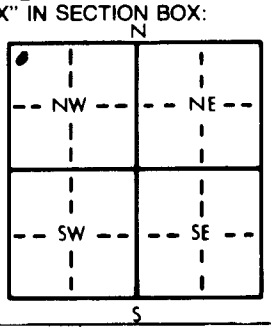

4 DEPTH OF COMPLETED WELL 111 ft. ELEVATION:

Depth(s) Groundwater Encountered 1. 23 ft. 2. 85-100 ft. 3. ft.

WELL'S STATIC WATER LEVEL 70 ft. below land surface measured on mo/day/yr 5-15-91

Pump test data: Well water was ft. after hours pumping gpm

Est. Yield 2.6 PM gpm: Well water was ft. after hours pumping gpm

Bore Hole Diameter 10 in. to 111 ft., and in. to ft.

WELL WATER TO BE USED AS: (1) Domestic 2 Irrigation 3 Feedlot 4 Industrial 5 Public water supply 6 Oil field water supply 7 Lawn and garden only 8 Air conditioning 9 Dewatering 10 Monitoring well 11 Injection well 12 Other (Specify below)

Was a chemical/bacteriological sample submitted to Department? Yes No ✓; If yes, mo/day/yr sample was submitted

Water Well Disinfected? Yes ✓ No

5 TYPE OF BLANK CASING USED: 1 Steel (2) PVC 3 RMP (SR) 4 ABS 5 Wrought iron 6 Asbestos-Cement 7 Fiberglass 8 Concrete tile 9 Other (specify below)

CASING JOINTS: Glued Clamped Welded Threaded

Blank casing diameter 6" in. to 85 ft., Dia in. to ft., Dia in. to ft.

Casing height above land surface 18" in., weight lbs./ft. Wall thickness or gauge No. Sch 40

TYPE OF SCREEN OR PERFORATION MATERIAL: 1 Steel 2 Brass 3 Stainless steel 4 Galvanized steel 5 Fiberglass 6 Concrete tile 7 PVC 8 RMP (SR) 9 ABS 10 Asbestos-cement 11 Other (specify) 12 None used (open hole)

SCREEN OR PERFORATION OPENINGS ARE: 1 Continuous slot 2 Louvered shutter 3 Mill slot 4 Key punched 5 Gauzed wrapped 6 Wire wrapped 7 Torch cut (8) Saw cut 9 Drilled holes 10 Other (specify) 11 None (open hole)

SCREEN-PERFORATED INTERVALS: From 71 ft. to 111 ft., From ft. to ft.

From ft. to ft., From ft. to ft.

GRAVEL PACK INTERVALS: From 10 ft. to 35 ft., From ft. to ft.

From ft. to ft., From ft. to ft.

6 GROUT MATERIAL: 1 Neat cement (2) Cement grout 3 Bentonite 4 Other

Grout Intervals: From 35 ft. to 85 ft., From 0 ft. to 10' ft., From ft. to ft.

What is the nearest source of possible contamination: 1 Septic tank 2 Sewer lines 3 Watertight sewer lines 4 Lateral lines 5 Cess pool 6 Seepage pit 7 Pit privy 8 Sewage lagoon 9 Feedyard 10 Livestock pens 11 Fuel storage 12 Fertilizer storage 13 Insecticide storage 14 Abandoned water well (5) Oil well/Gas well 16 Other (specify below)

Direction from well? S.W. How many feet? 700'

FROM	TO	LITHOLOGIC LOG	FROM	TO	PLUGGING INTERVALS
0	7	Yellow Clay			6" 10 Packer
7	33	Sand Rock-Yellow 1GPM-23			At. 85. open Hole
33	35	Shale Blue			to. 111 ft.
35	85	Sand Rock-yellow-(Thief)			
85	100	Sand White-Fine 1GPM			
100	111	Sandy Shale			
		T.D 111			

7 CONTRACTOR'S OR LANDOWNER'S CERTIFICATION: This water well was (1) (constructed) (2) reconstructed, or (3) plugged under my jurisdiction and was completed on (mo/day/year) 5-18-91 and this record is true to the best of my knowledge and belief. Kansas Water Well Contractor's License No. 412 This Water Well Record was completed on (mo/day/yr) under the business name of C. B. Darnall by (signature) Charles B. Darnall

INSTRUCTIONS: Use typewriter or ball point pen. *PLEASE PRESS FIRMLY* and *PRINT* clearly. Please fill in blanks, underline or circle the correct answers. Send top three copies to Kansas Department of Health and Environment, Bureau of Water, Topeka, Kansas 66620-7320. Telephone: 913-296-5545. Send one to WATER WELL OWNER and retain one for your records.

OFFICE USE ONLY T R E/W SEC. ¼ ¼ ¼