

Geraghty-Miller - John

WATER WELL RECORD

Form WWC-5

KSA 82a-1212

Inv. 5296

MW-2

1 LOCATION OF WATER WELL:	Fraction	Section Number	Township Number	Range Number
County: <u>Chautauqua</u>	<u>NW 1/4 NW 1/4 NE 1/4</u>	<u>15</u>	T <u>34</u> S	R <u>12</u> <u>EN</u>

Distance and direction from nearest town or city street address of well if located within city?
1 mile NE of Peru, Kansas


2 WATER WELL OWNER: Roch

RR#, St. Address, Box # : _____

City, State, ZIP Code : Peru, Kansas

Board of Agriculture, Division of Water Resources
Application Number: _____

3 LOCATE WELL'S LOCATION WITH AN "X" IN SECTION BOX:

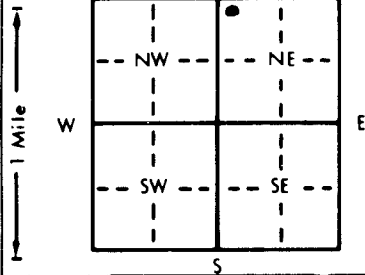

4 DEPTH OF COMPLETED WELL: 20 ft. ELEVATION: _____

Depth(s) Groundwater Encountered 1. _____ ft. 2. _____ ft. 3. _____ ft.

WELL'S STATIC WATER LEVEL _____ ft. below land surface measured on mo/day/yr

Pump test data: Well water was _____ ft. after _____ hours pumping _____ gpm

Est. Yield _____ gpm: Well water was _____ ft. after _____ hours pumping _____ gpm

Bore Hole Diameter _____ in. to _____ ft., and _____ in. to _____ ft.

WELL WATER TO BE USED AS:

5 Public water supply	8 Air conditioning	11 Injection well
1 Domestic	3 Feedlot	6 Oil field water supply
2 Irrigation	4 Industrial	7 Lawn and garden only
		10 Monitoring well
		9 Dewatering
		12 Other (Specify below)

Was a chemical/bacteriological sample submitted to Department? Yes _____ No _____; If yes, mo/day/yr sample was submitted _____

Water Well Disinfected? Yes _____ No _____

5 TYPE OF BLANK CASING USED:

1 Steel	3 RMP (SR)	5 Wrought iron	8 Concrete tile	CASING JOINTS: Glued _____ Clamped _____
2 PVC	4 ABS	6 Asbestos-Cement	9 Other (specify below)	Welded _____
		7 Fiberglass		Threaded _____

Blank casing diameter 2 in. to _____ ft., Dia _____ in. to _____ ft., Dia _____ in. to _____ ft.

Casing height above land surface _____ in., weight _____ lbs./ft. Wall thickness or gauge No. _____

TYPE OF SCREEN OR PERFORATION MATERIAL:

1 Steel	3 Stainless steel	5 Fiberglass	8 RMP (SR)	10 Asbestos-cement	11 Other (specify) _____
2 Brass	4 Galvanized steel	6 Concrete tile	9 ABS	12 None used (open hole)	

SCREEN OR PERFORATION OPENINGS ARE:

1 Continuous slot	3 Mill slot	5 Gauzed wrapped	8 Saw cut	11 None (open hole)
2 Louvered shutter	4 Key punched	6 Wire wrapped	9 Drilled holes	
		7 Torch cut	10 Other (specify) _____	

SCREEN-PERFORATED INTERVALS: From _____ ft. to _____ ft., From _____ ft. to _____ ft.

GRAVEL PACK INTERVALS: From _____ ft. to _____ ft., From _____ ft. to _____ ft.

6 GROUT MATERIAL: 1 Neat cement 2 Cement grout 3 Bentonite 4 Other

GROUT INTERVALS: From _____ ft. to _____ ft., From _____ ft. to _____ ft.

What is the nearest source of possible contamination:

FROM	TO	LITHOLOGIC LOG	FROM	TO	PLUGGING INTERVALS
			<u>20</u>	<u>10</u>	<u>Asphaltum</u>
			<u>10</u>	<u>4</u>	<u>Concrete</u>
			<u>4</u>	<u>0</u>	<u>Dirt</u>

7 CONTRACTOR'S OR LANDOWNER'S CERTIFICATION: This water well was (1) constructed, (2) reconstructed, or (3) plugged under my jurisdiction and was completed on (mo/day/year) 3-11-98 and this record is true to the best of my knowledge and belief. Kansas

Water Well Contractor's License No. 607 This Water Well Record was completed on (mo/day/yr) _____ under the business name of Davis Environmental Drilling LLC by (signature) [Signature]

INSTRUCTIONS: Use typewriter or ball point pen. PLEASE PRESS FIRMLY and PRINT clearly. Please fill in blanks, underline or circle the correct answers. Send top three copies to Kansas Department of Health and Environment, Bureau of Water, Topeka, Kansas 66620-0001. Telephone: 913-296-5545. Send one to WATER WELL OWNER and retain one for your records.