


1 LOCATION OF WATER WELL: Fraction SW 1/4 NW 1/4 SE 1/4 Section Number 18 Township Number T 34 S Range Number R 14 E/W  
 County: Montgomery

Distance and direction from nearest town or city street address of well if located within city?  
Mile + 1/2 East of Havana and 1/2 mile South

2 WATER WELL OWNER: D.D. Gilstrap  
 RR#, St. Address, Box #: 910 N. 6th Independence, Ken Board of Agriculture, Division of Water Resources  
 City, State, ZIP Code: Ken Application Number:

3 LOCATE WELL'S LOCATION WITH AN "X" IN SECTION BOX:

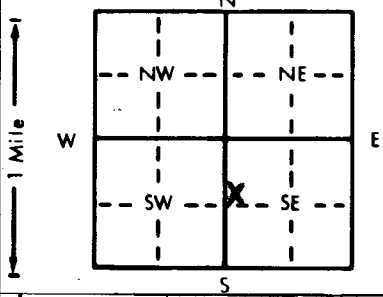

4 DEPTH OF COMPLETED WELL: 110 ft. ELEVATION:

Depth(s) Groundwater Encountered 1. 25 ft. 2. 80 ft. 3.     ft.  
 WELL'S STATIC WATER LEVEL 17 1/2 ft. below land surface measured on mo/day/yr Nov 6, 82  
 Pump test data: Well water was     ft. after     hours pumping     gpm  
 Est. Yield 8 gpm: Well water was     ft. after     hours pumping     gpm  
 Bore Hole Diameter: 10 in. to 12 ft., and 6 in. to 110 ft.  
 WELL WATER TO BE USED AS:  
 5 Public water supply 8 Air conditioning 11 Injection well  
1 Domestic 3 Feedlot 6 Oil field water supply 9 Dewatering 12 Other (Specify below)  
 2 Irrigation 4 Industrial 7 Lawn and garden only 10 Observation well  
 Was a chemical/bacteriological sample submitted to Department? Yes     No ; If yes, mo/day/yr sample was submitted  
 Water Well Disinfected? Yes  No    

5 TYPE OF BLANK CASING USED:  
 1 Steel 3 RMP (SR) 5 Wrought iron 8 Concrete tile CASING JOINTS: Glued     Clamped      
 2 PVC 4 ABS 6 Asbestos-Cement 9 Other (specify below) Welded      
 7 Fiberglass Threaded      
 Blank casing diameter 6 in. to     ft., Dia     in. to     ft., Dia     in. to     ft.  
 Casing height above land surface 12 in., weight     lbs./ft. Wall thickness or gauge No. SDR 26

TYPE OF SCREEN OR PERFORATION MATERIAL:  
 1 Steel 3 Stainless steel 5 Fiberglass 7 PVC 10 Asbestos-cement  
 2 Brass 4 Galvanized steel 6 Concrete tile 8 RMP (SR) 11 Other (specify)      
 9 ABS 12 None used (open hole)

SCREEN OR PERFORATION OPENINGS ARE:  
 1 Continuous slot 3 Mill slot 5 Gauzed wrapped 8 Saw cut 11 None (open hole)  
 2 Louvered shutter 4 Key punched 6 Wire wrapped 9 Drilled holes  
 7 Torch cut 10 Other (specify)    

SCREEN-PERFORATED INTERVALS: From     ft. to     ft., From     ft. to     ft.  
 From     ft. to     ft., From     ft. to     ft.  
 GRAVEL PACK INTERVALS: From     ft. to     ft., From     ft. to     ft.  
 From     ft. to     ft., From     ft. to     ft.

6 GROUT MATERIAL: 1 Neat cement 2 Cement grout 3 Bentonite 4 Other      
 Grout intervals: From 2 ft. to 12 ft., From     ft. to     ft., From     ft. to     ft.

What is the nearest source of possible contamination:  
 1 Sepic tank 4 Lateral lines 7 Pit privy 10 Livestock pens 14 Abandoned water well  
 2 Sewer lines 5 Cess pool 8 Sewage lagoon 11 Fuel storage 15 Oil well/Gas well  
 3 Watertight sewer lines 6 Seepage pit 9 Feedyard 12 Fertilizer storage 16 Other (specify below)  
 13 Insecticide storage  
 Direction from well? South How many feet? 50

FROM	TO	LITHOLOGIC LOG	FROM	TO	LITHOLOGIC LOG
0	2	Soil			
2	10	Sand Rock			
10	55	Shale			
55	59	Sand			
59	60	Lime			
60	63	Shale			
63	64	Lime			
64	70	Shale			
70	71	Lime			
71	74	Shale			
74	80	Lime			
80	110	White water Sand			

7 CONTRACTOR'S OR LANDOWNER'S CERTIFICATION: This water well was (1) constructed, (2) reconstructed, or (3) plugged under my jurisdiction and was completed on (mo/day/year) Nov 6 1982 and this record is true to the best of my knowledge and belief. Kansas Water Well Contractor's License No. 393 This Water Well Record was completed on (mo/day/yr) Nov 7 82 under the business name of Country Water by (signature) Ray Weber

INSTRUCTIONS: Use typewriter or ball point pen. PLEASE PRESS FIRMLY and PRINT clearly. Please fill in blanks, underline or circle the correct answers. Send top three copies to Kansas Department of Health and Environment, Division of Environment, Environmental Geology Section, Topeka, KS 66620. Send one to WATER WELL OWNER and retain one for your records.