


1 LOCATION OF WATER WELL: County: Montgomery Fraction: NE 1/4 NE 1/4 SE 1/4 Section Number: 36 Township Number: T 34 S Range Number: R 14 E/W
 Distance and direction from nearest town or city street address of well if located within city? North of Tyree County Road 2700

2 WATER WELL OWNER: Jack Shamblin
 RR#, St. Address, Box #: 1861 County Road 2700
 City, State, ZIP Code: Caney KS 67333
 Board of Agriculture, Division of Water Resources
 Application Number:

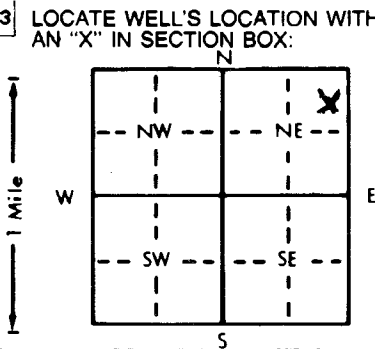

4 DEPTH OF COMPLETED WELL: 138 ft. ELEVATION: ft.
 Depth(s) Groundwater Encountered: 1. ft. 2. ft. 3. ft.
 WELL'S STATIC WATER LEVEL: 10 ft. below land surface measured on mo/day/yr
 Bore Hole Diameter: 8 in. to 120 ft., and in. to ft.
 WELL WATER TO BE USED AS:
 Domestic 3 Feedlot 6 Oil field water supply 9 Dewatering 12 Other (Specify below)
 2 Irrigation 4 Industrial 7 Lawn and garden only 10 Monitoring well
 Was a chemical/bacteriological sample submitted to Department? Yes No ; If yes, mo/day/yr sample was submitted
 Water Well Disinfected? Yes No

5 TYPE OF BLANK CASING USED:
 1 Steel 3 RMP (SR) 5 Wrought iron 8 Concrete tile CASING JOINTS: Glued Clamped
 2 PVC 4 ABS 6 Asbestos-Cement 9 Other (specify below) Welded
 7 Fiberglass Threaded
 Blank casing diameter in. to ft. Dia in. to ft. Dia in. to ft.
 Casing height above land surface: 18 in. weight 50H lbs./ft. Wall thickness or gauge No. 160
 TYPE OF SCREEN OR PERFORATION MATERIAL:
 7 PVC 10 Asbestos-cement
 1 Steel 3 Stainless steel 5 Fiberglass 8 RMP (SR) 11 Other (specify)
 2 Brass 4 Galvanized steel 6 Concrete tile 9 ABS 12 None used (open hole)
 SCREEN OR PERFORATION OPENINGS ARE:
 3 Mill slot 5 Gauzed wrapped 8 Saw cut 11 None (open hole)
 1 Continuous slot 6 Wire wrapped 9 Drilled holes
 2 Louvered shutter 4 Key punched 7 Torch cut 10 Other (specify)
 SCREEN-PERFORATED INTERVALS: From 120 ft. to 100 ft. From ft. to ft.
 GRAVEL PACK INTERVALS: From 120 ft. to 2160 ft. From ft. to ft.

6 GROUT MATERIAL: 1 Neat cement 2 Cement grout 3 Bentonite 4 Other
 Grout intervals: From 20 ft. to 0 ft. From ft. to ft. From ft. to ft.
 What is the nearest source of possible contamination:
 1 Septic tank 4 Lateral lines 7 Pit privy 10 Livestock pens 14 Abandoned water well
 2 Sewer lines 5 Cess pool 8 Sewage lagoon 11 Fuel storage 15 Oil well/Gas well
 3 Watertight sewer lines 6 Seepage pit 9 Feedyard 12 Fertilizer storage 16 Other (specify below)
 Direction from well? How many feet? 150

| FROM | TO | LITHOLOGIC LOG | FROM | TO | PLUGGING INTERVALS |
|------|-----|-------------------|------|----|--------------------|
| 0 | 5 | SOIL | | | |
| 5 | 10 | CLAY | | | |
| 10 | 20 | SHALE | | | |
| 20 | 23 | rock limo | | | |
| 23 | 30 | yellow clay | | | |
| 30 | 35 | gravel clay water | | | |
| 35 | 40 | SHALE | | | |
| 40 | 42 | limo | | | |
| 42 | 60 | 119H SHALE | | | |
| 60 | 62 | limo | | | |
| 62 | 100 | SHALE | | | |
| 100 | 103 | DARK limo | | | |
| 103 | 120 | SHALE | | | |

7 CONTRACTOR'S OR LANDOWNER'S CERTIFICATION: This water well was (1) constructed (2) reconstructed, or (3) plugged under my jurisdiction and was completed on (mo/day/year) 7-31-98 and this record is true to the best of my knowledge and belief. Kansas Water Well Contractor's License No. 512 This Water Well Record was completed on (mo/day/yr) 7-31-98 under the business name of Jeffery Well Drilling by (signature) Jack Shamblin

INSTRUCTIONS: Use typewriter or ball point pen. PLEASE PRESS FIRMLY and PRINT clearly. Please fill in blanks, underline or circle the correct answers. Send top three copies to Kansas Department of Health and Environment, Bureau of Water, Topeka, Kansas 66620-0001. Telephone: 913-296-5545. Send one to WATER WELL OWNER and retain one for your records.