


1 LOCATION OF WATER WELL: Fraction NE 1/4 NW 1/4 SE 1/4 Section Number 14 Township Number T 34 S Range Number R 15 E

County MONTGOMERY Distance and direction from nearest town or city street address of well if located within city: 5 miles
 BITT WADDELL 3 Miles E. 1 1/2 Miles So. 1 Mile W. of Jefferson, KS

2 WATER WELL OWNER: BOX 403 RR# 1 INDEPENDENCE, KS. 67301 Board of Agriculture, Division of Water Resources Application Number:

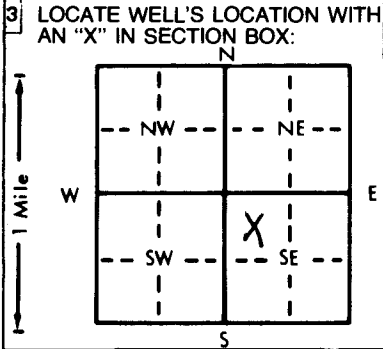

4 DEPTH OF COMPLETED WELL 100 ft. ELEVATION: 82 ft.
 Depth(s) Groundwater Encountered 1 28 ft. 2 82 ft. 3 .ft.
 WELL'S STATIC WATER LEVEL 35 ft. below land surface measured on mo/day/yr 6-14-84
 Pump test data: Well water was .ft. after . hours pumping . gpm
 Est. Yield 10 gpm: Well water was .ft. after . hours pumping . gpm
 Bore Hole Diameter 10 in. to 20 ft., and 6 in. to 100 ft.
 WELL WATER TO BE USED AS:
 1 Domestic 2 Irrigation 3 Feedlot 4 Industrial 5 Public water supply 6 Oil field water supply 7 Lawn and garden only 8 Air conditioning 9 Dewatering 10 Observation well 11 Injection well 12 Other (Specify below)
 Was a chemical/bacteriological sample submitted to Department? Yes . No X; If yes, mo/day/yr sample was submitted Water Well Disinfected? Yes No X

5 TYPE OF BLANK CASING USED:
 1 Steel 2 PVC 3 RMP (SR) 4 ABS 5 Wrought iron 6 Asbestos-Cement 7 Fiberglass 8 Concrete tile 9 Other (specify below)
 Blank casing diameter 6 in. to 20 ft., Dia 160 in. to .ft., Dia . in. to .ft.
 Casing height above land surface 12 in., weight 160 lbs./ft. Wall thickness or gauge No. 1/4"
 TYPE OF SCREEN OR PERFORATION MATERIAL:
 1 Steel 2 Brass 3 Stainless steel 4 Galvanized steel 5 Fiberglass 6 Concrete tile 7 PVC 8 RMP (SR) 9 ABS 10 Asbestos-cement 11 Other (specify) 12 None used (open hole)
 SCREEN OR PERFORATION OPENINGS ARE:
 1 Continuous slot 2 Louvered shutter 3 Mill slot 4 Key punched 5 Gauzed wrapped 6 Wire wrapped 7 Torch cut 8 Saw cut 9 None (open hole)
 SCREEN-PERFORATED INTERVALS: From .ft. to .ft., From .ft. to .ft., From .ft. to .ft.
 GRAVEL PACK INTERVALS: From .ft. to .ft., From .ft. to .ft., From .ft. to .ft.

6 GROUT MATERIAL: 1 Neat cement 2 Cement grout 3 Bentonite 4 Other
 Grout Intervals: From 0 ft. to 20 ft., From .ft. to .ft., From .ft. to .ft.
 What is the nearest source of possible contamination: 100'
 1 Septic tank 2 Sewer lines 3 Watertight sewer lines 4 Lateral lines 5 Cess pool 6 Seepage pit 7 Pit privy 8 Sewage lagoon 9 Feedyard 10 Livestock pens 11 Fuel storage 12 Fertilizer storage 13 Insecticide storage 14 Abandoned water well 15 Oil well/Gas well 16 Other (specify below)
 Direction from well? South West 100' N. How many feet? 100'

FROM	TO	LITHOLOGIC LOG	FROM	TO	LITHOLOGIC LOG
0	3	01 Soil			
3	16	23 SAND STONE			
16	18	19 SHALE			
18	32	23 SAND STONE			
32	58	19 BLUE SHALE			
58	74	20 LIME			
74	82	19 SHALE			
82	84	05 SAND WATER			
84	100	19 SHALE GRAY			

7 CONTRACTOR'S OR LANDOWNER'S CERTIFICATION: This water well was constructed (2) reconstructed, or (3) plugged under my jurisdiction and was completed on (mo/day/year) 6-13-84 and this record is true to the best of my knowledge and belief. Kansas Water Well Contractor's License No. 454 This Water Well Record was completed on (mo/day/yr) 6-15-84 under the business name of Gene's Water Well Services by signature Arnold E. Bellmyer

INSTRUCTIONS: Use typewriter or ball point pen, PLEASE PRESS FIRMLY and PRINT clearly. Please fill in blanks, underline or circle the correct answers. Send top three copies to Kansas Department of Health and Environment, Division of Environment, Environmental Geology Section, Topeka, KS 66620. Send one to WATER WELL OWNER and retain one for your records.

OFFICE USE ONLY T 34 R 15 E W SEC.

D