


1 LOCATION OF WATER WELL: Fraction SW 1/4 NE 1/4 SW 1/4 Section Number 14 Township Number T 34 S Range Number R 15 E  
 County: MONTGOMERY

Distance and direction from nearest town or city street address of well if located within city?  
3 M. EAST 1/2 m. So. 1 mile W. JEFFERSON, Ks.

2 WATER WELL OWNER: Bill WADDIE  
 RR#, St. Address, Box #: RR 2, Box 403 Board of Agriculture, Division of Water Resources  
 City, State, ZIP Code: INDEPENDENCE, Ks. 67301 Application Number:

3 LOCATE WELL'S LOCATION WITH AN "X" IN SECTION BOX:

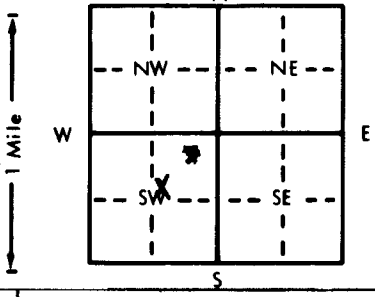

4 DEPTH OF COMPLETED WELL: 100 ft. ELEVATION:  
 Depth(s) Groundwater Encountered 1. 28 ft. 2. 82 ft. 3. \_\_\_\_\_ ft.  
 WELL'S STATIC WATER LEVEL: 35 ft. below land surface measured on mo/day/yr 6-14-84  
 Pump test data: Well water was \_\_\_\_\_ ft. after \_\_\_\_\_ hours pumping \_\_\_\_\_ gpm  
 Est. Yield: 10 gpm; Well water was \_\_\_\_\_ ft. after \_\_\_\_\_ hours pumping \_\_\_\_\_ gpm  
 Bore Hole Diameter: 10 in. to 20 ft., and 6 in. to 100 ft.  
 WELL WATER TO BE USED AS:  
 Domestic     Feedlot     Oil field water supply     Dewatering     Injection well  
 Irrigation     Industrial     Lawn and garden only     Observation well  
 Was a chemical/bacteriological sample submitted to Department? Yes \_\_\_\_\_ No ; If yes, mo/day/yr sample was submitted  
 Water Well Disinfected? Yes  No

5 TYPE OF BLANK CASING USED:  
 2 PVC     4 ABS     7 Fiberglass  
 1 Steel     3 RMP (SR)     6 Asbestos-Cement     9 Other (specify below)  
 Blank casing diameter: 6 in. to 20 ft., Dia \_\_\_\_\_ in. to \_\_\_\_\_ ft., Dia \_\_\_\_\_ in. to \_\_\_\_\_ ft.  
 Casing height above land surface: 12 in., weight 160 lbs./ft. Wall thickness or gauge No. #8 8a  
 TYPE OF SCREEN OR PERFORATION MATERIAL:  
 12 None used (open hole)  
 1 Steel     3 Stainless steel     5 Fiberglass     8 RMP (SR)     11 Other (specify)  
 2 Brass     4 Galvanized steel     6 Concrete tile     9 ABS  
 SCREEN OR PERFORATION OPENINGS ARE:  
 11 None (open hole)  
 1 Continuous slot     3 Mill slot     6 Wire wrapped     9 Drilled holes  
 2 Louvered shutter     4 Key punched     7 Torch cut     10 Other (specify)  
 SCREEN-PERFORATED INTERVALS: From \_\_\_\_\_ ft. to \_\_\_\_\_ ft., From \_\_\_\_\_ ft. to \_\_\_\_\_ ft.  
 GRAVEL PACK INTERVALS: From \_\_\_\_\_ ft. to \_\_\_\_\_ ft., From \_\_\_\_\_ ft. to \_\_\_\_\_ ft.

6 GROUT MATERIAL:  1 Neat cement     2 Cement grout     3 Bentonite     4 Other  
 Grout Intervals: From 0 ft. to 20 ft., From \_\_\_\_\_ ft. to \_\_\_\_\_ ft., From \_\_\_\_\_ ft. to \_\_\_\_\_ ft.  
 What is the nearest source of possible contamination: 150  
 1 Septic tank     4 Lateral lines     7 Pit privy     10 Livestock pens     14 Abandoned water well  
 2 Sewer lines     5 Cess pool     8 Sewage lagoon     11 Fuel storage     15 Oil well/Gas well  
 3 Watertight sewer lines     6 Seepage pit     9 Feedyard     12 Fertilizer storage     16 Other (specify below)  
 13 Insecticide storage  
 Direction from well? So. West 150' How many feet?

FROM	TO	LITHOLOGIC LOG	FROM	TO	LITHOLOGIC LOG
0	3	Soil			
3	16	SAND STONE			
16	18	SHALE			
18	32	SAND STONE			
32	58	BLUE SHALE			
58	74	LIME			
74	82	SHALE			
82	84	SAND WATER			
84	100	SHALE - GRAY			

7 CONTRACTOR'S OR LANDOWNER'S CERTIFICATION: This water well was (1) constructed, (2) reconstructed, or (3) plugged under my jurisdiction and was completed on (mo/day/year) 6-12-84 and this record is true to the best of my knowledge and belief. Kansas Water Well Contractor's License No. 454 This Water Well Record was completed on (mo/day/yr) 6-18-84 under the business name of Gene's Waterwell Service by (signature) Bill Waddie

INSTRUCTIONS: Use typewriter or ball point pen, PLEASE PRESS FIRMLY and PRINT clearly. Please fill in blanks, underline or circle the correct answers. Send top three copies to Kansas Department of Health and Environment, Division of Environment, Environmental Geology Section, Topeka, KS 66620. Send one to WATER WELL OWNER and retain one for your records.

OFFICE USE ONLY  
T  
R  
EW  
SEC.  
1/4  
1/4  
1/4