


1 LOCATION OF WATER WELL: County: **Montgomery** Fraction: **SE 1/4 SW 1/4 NW 1/4** Section Number: **33** Township Number: **T 34 S** Range Number: **R 15 EW**

Distance and direction from nearest town or city street address of well if located within city? **3806 W 1st Coffeyville**

2 WATER WELL OWNER: **Kenneth Madden**
 RR#, St. Address, Box #: **3806 W 1st**
 City, State, ZIP Code: **Coffeyville, KS**
 Board of Agriculture, Division of Water Resources
 Application Number:

3 LOCATE WELL'S LOCATION WITH AN "X" IN SECTION BOX:

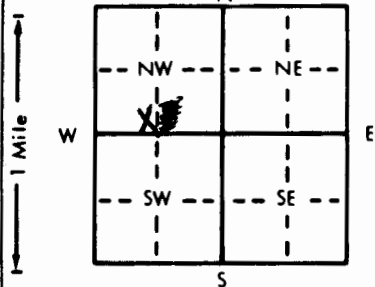

4 DEPTH OF COMPLETED WELL: **70** ft. ELEVATION:
 Depth(s) Groundwater Encountered: 1. **17** ft. 2. . ft. 3. . ft.
 WELL'S STATIC WATER LEVEL: **8** ft. below land surface measured on mo/day/yr
 Pump test data: Well water was . ft. after . hours pumping . gpm
 Est. Yield . gpm: Well water was . ft. after . hours pumping . gpm
 Bore Hole Diameter: **10** in. to **70** ft., and . in. to . ft.
 WELL WATER TO BE USED AS:
 5 Public water supply 8 Air conditioning 11 Injection well
 1 Domestic 3 Feedlot 6 Oil field water supply 9 Dewatering 12 Other (Specify below)
 Irrigation 4 Industrial 7 Lawn and garden only 10 Monitoring well
 Was a chemical/bacteriological sample submitted to Department? Yes . No ; If yes, mo/day/yr sample was submitted
 Water Well Disinfected? Yes . No

5 TYPE OF BLANK CASING USED:
 Steel 3 RMP (SR) 5 Wrought iron 8 Concrete tile CASING JOINTS: Glued Clamped .
 PVC 4 ABS 6 Asbestos-Cement 9 Other (specify below) Welded .
 7 Fiberglass . Threaded .
 Blank casing diameter: **6** in. to **70** ft., Dia . in. to . ft., Dia . in. to . ft.
 Casing height above land surface: **18** in., weight . lbs./ft. Wall thickness or gauge No. **SCH 40**

TYPE OF SCREEN OR PERFORATION MATERIAL: PVC 10 Asbestos-cement
 1 Steel 3 Stainless steel 5 Fiberglass 8 RMP (SR) 11 Other (specify) .
 2 Brass 4 Galvanized steel 6 Concrete tile 9 ABS 12 None used (open hole)

SCREEN OR PERFORATION OPENINGS ARE:
 1 Continuous slot Mill slot 5 Gauzed wrapped 8 Saw cut 11 None (open hole)
 2 Louvered shutter 4 Key punched 6 Wire wrapped 9 Drilled holes
 7 Torch cut 10 Other (specify) .

SCREEN-PERFORATED INTERVALS: From **50** ft. to **70** ft., From . ft. to . ft.
 From . ft. to . ft., From . ft. to . ft.
 GRAVEL PACK INTERVALS: From **15** ft. to **70** ft., From . ft. to . ft.
 From . ft. to . ft., From . ft. to . ft.

6 GROUT MATERIAL: Neat cement 2 Cement grout 3 Bentonite 4 Other .
 Grout intervals: From **0** ft. to **15** ft., From . ft. to . ft., From . ft. to . ft.

What is the nearest source of possible contamination:
 1 Septic tank 4 Lateral lines 7 Pit privy 10 Livestock pens 14 Abandoned water well
 Sewer lines 5 Cess pool 8 Sewage lagoon 11 Fuel storage 15 Oil well/Gas well
 3 Watertight sewer lines 6 Seepage pit 9 Feedyard 12 Fertilizer storage 16 Other (specify below)
 13 Insecticide storage
 Direction from well? **S** How many feet? **100**

FROM	TO	LITHOLOGIC LOG	FROM	TO	PLUGGING INTERVALS
0	4	Topsoil			
4	17	Red Clay			
17	20	Broken Limestone			
20	22	Fine Sand			
22	70	Gray Shale			

7 CONTRACTOR'S OR LANDOWNER'S CERTIFICATION: This water well was (1) constructed, (2) reconstructed, or (3) plugged under my jurisdiction and was completed on (mo/day/year) **06-07-89** and this record is true to the best of my knowledge and belief. Kansas Water Well Contractor's License No. **508** This Water Well Record was completed on (mo/day/yr) **06-09-89** under the business name of **Ashford Water Well Services** by (signature) *Teruy Ashford*