USE TYPEWRITER OR BALL POINT PEN-PRESS FIRMLY, PRINT CLEARLY.

WATER WELL RECORD
KSA 82a-1201-1215

Kansas Department of Health and Environment-Division of Environment
(Water well Contractors)
Topeka, Kansas 66620

1. Location of well:	County	Fraction	Section number	Township number	Range number
	MONTGOMERY	N 1/2 NW 1/4 1/4	36	T 34 S	R 15 E/W

2. Distance and direction from nearest town or city: 1/2 MILE SOUTH OF DEARING KANS, 1 1/8 mi W
Street address of well location if in city:

3. Owner of well: MELVIN JONTRA
R.R. or street: RT. #1 Box
City, state, zip code: COFFEYVILLE KANSAS

4. Locate with "X" in section below:

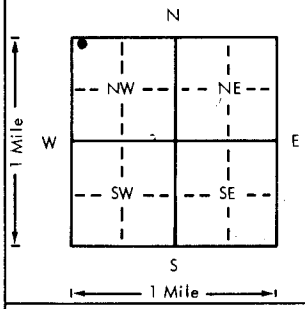

Sketch map:

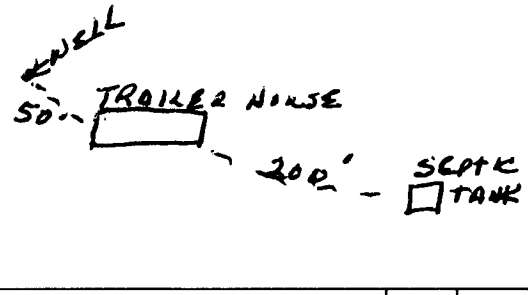

6. Bore hole dia. 9 in. Completion date
Well depth 35 ft. 8/19/78

7. X Cable tool __ Rotary __ Driven __ Dug
__ Hollow rod __ Jetted __ Bored __ Reverse rotary

8. Use: X Domestic __ Public supply __ Industry
__ Irrigation __ Air conditioning __ Stock
__ Lawn __ Oil field water __ Other

9. Casing: Material
Threaded ___ Welded ___
RMP ___ PVC SCH 40
Dia. 6 in. to 35 ft. depth
Dia. ___ in. to ___ ft. depth
Height: Above or below Surface 12 in.
Weight ___ lbs./ft.
Wall Thickness: inches or gage No. 10.320

10. X Screen: Manufacturer's name
Type ___ Dia. 6
Slot/gauze SLOT Length 20 FT.
Set between 15 ft. and 35 ft.
___ ft. and ___ ft.
Gravel pack? X Size range of material PEA

11. Static water level: mo./day/yr.
10 ft. below land surface Date 8/19/78

12. Pumping level below land surfaces:
___ ft. after ___ hrs. pumping ___ g.p.m.
___ ft. after ___ hrs. pumping ___ g.p.m.
Estimated maximum yield 3 g.p.m.

13. Water sample submitted: mo./day/yr.
__ Yes X No Date

14. Well head completion:
__ Pitless adapter ___ Inches above grade

15. Well grouted? YES
With: X Neat cement __ Bentonite __ Concrete
Depth: From 0 ft. to 10 ft.

16. Nearest source of possible contamination: NONE
ft. ___ Direction ___ Type
Well disinfected upon completion? X Yes __ No

17. Pump: X Not installed
Manufacturer's name
Model number ___ HP ___ Volts
Length of drop pipe ___ ft. capacity ___ g.p.m.
Type:
__ Submersible __ Turbine
__ Jet __ Reciprocating
__ Centrifugal __ Other

5. Type and color of material

	From	To
CLAY & GRAVEL	0	5
SAND ROCK	5	32
LIME	32	35

(Use a second sheet if needed)

18. Elevation:

Topography:
__ Hill
X Slope
__ Upland
__ Valley

19. Remarks: CUSTOMER KNOWS HE IS TO INSTALL CONCRETE SLAB

20. Water well contractor's certification:
This well was drilled under my jurisdiction and this report is true to the best of my knowledge and belief.
Business name MOORE DRILLING CO. License No. 345
Address DEARING KANS
Signed [signature] Date 8/19/78
Authorized representative

T 34 R 15 E/W Sec 36 1/4 1/4 1/4 1/4 NW/NW

Forward the white, blue and pink copies to the Department of Health and Environment

Form WWC-5

MI-1023