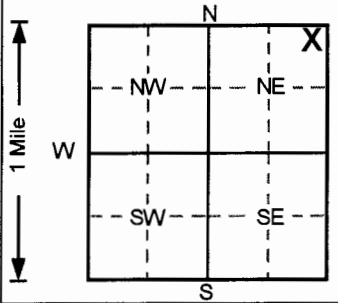


1 LOCATION OF WATER WELL: County: Montgomery	Fraction NE ¼ NE ¼ NE ¼	Section Number 36	Township Number T 34 S	Range Number R 16 EW
--	-----------------------------------	-----------------------------	----------------------------------	--

Distance and direction from nearest town or city street address of well if located within city?
400 N. Linden, Coffeyville, KS

2 WATER WELL OWNER: **Farmland Industries, Inc.**
 RR#, St. Address, Box # : **P.O. Box 570** Board of Agriculture, Division of Water Resources
 City, State, ZIP Code : **Coffeyville, Kansas 67337-0570** Application Number:

3 LOCATE WELL'S LOCATION WITH AN "X" IN SECTION BOX: 	4 DEPTH OF COMPLETED WELL 37.4 ft. ELEVATION: 725.48 Depth(s) Groundwater Encountered 1. 23.1 ft. 2. _____ ft. 3. _____ ft. WELL'S STATIC WATER LEVEL _____ ft. below land surface measured on mo/day/yr _____ Pump test data: Well water was NA ft. after _____ hours pumping _____ gpm Est. Yield NA gpm: Well water was _____ ft. after _____ hours pumping _____ gpm Bore Hole Diameter 8 in. to 37.4 ft., and _____ in. to _____ ft. WELL WATER TO BE USED AS: 5 Public water supply 8 Air conditioning 11 Injection well 1 Domestic 3 Feedlot 6 Oil field water supply 9 Dewatering 12 Other (Specify below) 2 Irrigation 4 Industrial 7 Lawn and garden only 10 Monitoring well _____ Was a chemical/bacteriological sample submitted to Department? Yes _____ No <input checked="" type="checkbox"/> ; If yes, mo/day/yr sample was submitted Water Well Disinfected? Yes _____ No <input checked="" type="checkbox"/>
--	--

5 TYPE OF BLANK CASING USED:
 1 Steel 3 RMP (SR) 5 Wrought iron 8 Concrete tile CASING JOINTS: Glued _____ Clamped _____
 2 **PVC** 4 ABS 6 Asbestos-Cement 9 Other (specify below) Welded _____
 7 Fiberglass _____ Threaded
 Blank casing diameter **2** in. to **17.5** ft., Dia _____ in. to _____ ft., Dia _____ in. to _____ ft.
 Casing height above land surface **29.04** in., weight _____ lbs./ft. Wall thickness or gauge No. **Sch. 40**
 TYPE OF SCREEN OR PERFORATION MATERIAL **7** PVC 10 Asbestos-cement
 1 Steel 3 Stainless steel 5 Fiberglass 8 RMP (SR) 11 Other (specify) _____
 2 Brass 4 Galvanized steel 6 Concrete tile 9 ABS 12 None used (open hole)
 SCREEN OR PERFORATION OPENINGS ARE:
1 Continuous slot 3 Mill slot 5 Gauzed wrapped 8 Saw cut 11 None (open hole)
 2 Louvered shutter 4 Key punched 6 Wire wrapped 9 Drilled holes
 7 Torch cut 10 Other (specify) _____
 SCREEN-PERFORATED INTERVALS: From **17.5** ft. to **37.4** ft., From _____ ft. to _____ ft.
 From _____ ft. to _____ ft., From _____ ft. to _____ ft.
 GRAVEL PACK INTERVALS: From **16** ft. to **37.4** ft., From _____ ft. to _____ ft.
 From _____ ft. to _____ ft., From _____ ft. to _____ ft.

6 GROUT MATERIAL: 1 Neat cement **2** Cement grout **3** Bentonite 4 Other _____
 Grout Intervals: From **0** ft. to **1** ft., From **1** ft. to **16** ft., From _____ ft. to _____ ft.
 What is the nearest source of possible contamination:
 1 Septic tank 4 Lateral lines 7 Pit privy 10 Livestock pens 14 Abandoned water well
 2 Sewer lines 5 Cess pool 8 Sewage lagoon 11 Fuel storage 15 Oil well/Gas well
 3 Watertight sewer lines 6 Seepage pit 9 Feedyard 12 Fertilizer storage **16** Other (specify below)
 _____ **Refinery Facility** _____
 Direction from well? **At Refinery** How many feet?

FROM	TO	LITHOLOGIC LOG	FROM	TO	PLUGGING INTERVALS
0	1	Rocks and Gravel,			
1	13.5	Clay, Dark Olive Gray to Black			
13.5	15.5	Clay, Black			
15.5	18.5	Clay, Dark Olive Gray			
18.5	22.5	Clay, Olive			
22.5	27	Clay, Olive Gray			
27	28	Clay, Dark Gray			
28	34.5	Clay, Dark Gray			
34.5	36	Silt, Olive			
36	36.25	Gravel, Light Yellow Brown			
36.25	37.4	Shale, Light Gray			
					RMW143, Abovegrade
					Project Name: Farmland Refinery-56 Wells
					GeoCore # 255

7 CONTRACTOR'S OR LANDOWNER'S CERTIFICATION: This water well was **(1)** constructed, (2) reconstructed, or (3) plugged under my jurisdiction and was completed on (mo/day/year) **12/20/95** and this record is true to the best of my knowledge and belief.
 Kansas Water Well Contractor's License No. **527** This Water Well Record was completed on (mo/day/yr) **12/27/95**
 under the business name of **GeoCore Services, Inc.** by (signature) *Bob Bell*