


1 LOCATION OF WATER WELL: County: Montgomery	Fraction NE ¼ NE ¼ NE ¼	Section Number 36	Township Number T 34 S	Range Number R 16 (EW)
--	-----------------------------------	-----------------------------	----------------------------------	---

Distance and direction from nearest town or city street address of well if located within city?

400 N. Linden, Coffeyville, KS

2 WATER WELL OWNER: **Farmland Industries, Inc.**
 RR#, St. Address, Box # : **P.O. Box 570**
 City, State, ZIP Code : **Coffeyville, Kansas 67337-0570**
 Board of Agriculture, Division of Water Resources
 Application Number:

3 LOCATE WELL'S LOCATION WITH AN "X" IN SECTION BOX:

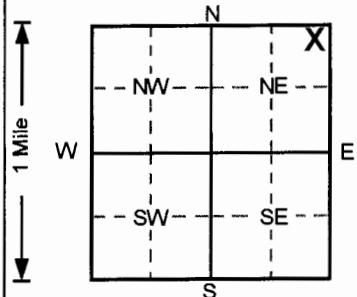

4 DEPTH OF COMPLETED WELL **27** ft. ELEVATION: **726.35**
 Depth(s) Groundwater Encountered 1. **21.56** ft. 2. ft. 3. ft.
 WELL'S STATIC WATER LEVEL ft. below land surface measured on mo/day/yr
 Pump test data: Well water was **NA** ft. after hours pumping gpm
 Est. Yield .. **NA** .. gpm: Well water was ft. after hours pumping gpm
 Bore Hole Diameter **8** in. to **40.5** ft., and in. to ft.
 WELL WATER TO BE USED AS: 5 Public water supply 8 Air conditioning 11 Injection well
 1 Domestic 3 Feedlot 6 Oil field water supply 9 Dewatering 12 Other (Specify below)
 2 Irrigation 4 Industrial 7 Lawn and garden only **10 Monitoring well**
 Was a chemical/bacteriological sample submitted to Department? Yes.....No**✓**.....; If yes, mo/day/yr sample was submitted
 Water Well Disinfected? Yes No **✓**

5 TYPE OF BLANK CASING USED: 5 Wrought iron 8 Concrete tile CASING JOINTS: Glued Clamped
 1 Steel 3 RMP (SR) 6 Asbestos-Cement 9 Other (specify below) Welded
2 PVC 4 ABS 7 Fiberglass Threaded. **✓**
 Blank casing diameter **2** in. to **17** ft., Dia in. to ft., Dia in. to ft.
 Casing height above land surface **24.72** in., weight lbs./ft. Wall thickness or gauge No. **Sch. 40**
 TYPE OF SCREEN OR PERFORATION MATERIAL **7** PVC 10 Asbestos-cement
 1 Steel 3 Stainless steel 5 Fiberglass 8 RMP (SR) 11 Other (specify)
 2 Brass 4 Galvanized steel 6 Concrete tile 9 ABS 12 None used (open hole)
 SCREEN OR PERFORATION OPENINGS ARE:
1 Continuous slot 3 Mill slot 5 Gauzed wrapped 8 Saw cut 11 None (open hole)
 2 Louvered shutter 4 Key punched 6 Wire wrapped 9 Drilled holes
 7 Torch cut 10 Other (specify)
 SCREEN-PERFORATED INTERVALS: From **17** ft. to **27** ft., From ft. to ft.
 From ft. to ft., From ft. to ft.
 GRAVEL PACK INTERVALS: From **16** ft. to **40.5** ft., From ft. to ft.
 From ft. to ft., From ft. to ft.

6 GROUT MATERIAL: 1 Neat cement **2** Cement grout **3** Bentonite 4 Other
 Grout Intervals: From **0** ft. to **1** ft., From **1** ft. to **16** ft., From ft. to ft.
 What is the nearest source of possible contamination:
 1 Septic tank 4 Lateral lines 7 Pit privy 10 Livestock pens 14 Abandoned water well
 2 Sewer lines 5 Cess pool 8 Sewage lagoon 11 Fuel storage 15 Oil well/Gas well
 3 Watertight sewer lines 6 Seepage pit 9 Feedyard 12 Fertilizer storage **16** Other (specify below)
 .. **Refinery Facility**
 Direction from well? **At Refinery** How many feet?

FROM	TO	LITHOLOGIC LOG	FROM	TO	PLUGGING INTERVALS
0	0.5	Gravel,			
0.5	9	Clay, Very Dark Brown to Very Dark Gray			
9	14	Clay, Dark Olive Gray			
14	15	Clay, Black			
15	20	Clay, Very Dark Gray			
20	24	Clay, Olive			
24	26	Clay, Olive Gray			
26	30.5	Sand, Olive Gray			
30.5	39	Gravel, Dark Brown			
39	40.5	Limestone, Light Olive Gray			
					RMW137, Abovegrade
					Project Name: Farmland Refinery-56 Wells
					GeoCore # 255

7 CONTRACTOR'S OR LANDOWNER'S CERTIFICATION: This water well was **(1)** constructed, (2) reconstructed, or (3) plugged under my jurisdiction and was completed on (mo/day/year) **12/19/95** and this record is true to the best of my knowledge and belief.
 Kansas Water Well Contractor's License No. **527** This Water Well Record was completed on (mo/day/yr) **12/27/95**
 under the business name of **GeoCore Services, Inc.** by (signature) *Paul R. [Signature]*