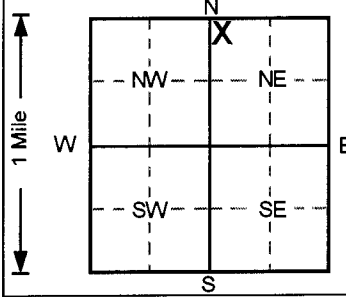


1 LOCATION OF WATER WELL: County: <b>Montgomery</b>	Fraction <b>NW ¼ NW ¼ NE ¼</b>	Section Number <b>36</b>	Township Number <b>T 34 S</b>	Range Number <b>R 16</b> <span style="border: 1px solid black; border-radius: 50%; padding: 2px;">EW</span>
--	-----------------------------------	-----------------------------	----------------------------------	--

Distance and direction from nearest town or city street address of well if located within city?  
**400 N. Linden, Coffeyville, KS**

2 WATER WELL OWNER: **Farmland Industries, Inc.**  
 RR#, St. Address, Box # : **P.O. Box 570** Board of Agriculture, Division of Water Resources  
 City, State, ZIP Code : **Coffeyville, Kansas 67337-0570** Application Number:

3 LOCATE WELL'S LOCATION WITH AN "X" IN SECTION BOX:  	4 DEPTH OF COMPLETED WELL ..... <b>20</b> ..... ft. ELEVATION: ..... <b>726.1</b> ..... Depth(s) Groundwater Encountered 1. .... <b>13.9</b> ..... ft. 2. .... ft. 3. .... ft. WELL'S STATIC WATER LEVEL ..... ft. below land surface measured on mo/day/yr ..... Pump test data: Well water was ..... <b>NA</b> ..... ft. after ..... hours pumping ..... gpm Est. Yield .. <b>NA</b> .. gpm: Well water was ..... ft. after ..... hours pumping ..... gpm Bore Hole Diameter .... <b>8</b> ..... in. to .... <b>28.7</b> ..... ft., and ..... in. to ..... ft. WELL WATER TO BE USED AS: 5 Public water supply 8 Air conditioning 11 Injection well 1 Domestic 3 Feedlot 6 Oil field water supply 9 Dewatering 12 Other (Specify below) 2 Irrigation 4 Industrial 7 Lawn and garden only <b>10</b> Monitoring well Was a chemical/bacteriological sample submitted to Department? Yes.....No..... <input checked="" type="checkbox"/> ; If yes, mo/day/yr sample was submitted Water Well Disinfected? Yes No <input checked="" type="checkbox"/>
--	---

5 TYPE OF BLANK CASING USED: 5 Wrought iron 8 Concrete tile CASING JOINTS: Glued ..... Clamped .....  
 1 Steel 3 RMP (SR) 6 Asbestos-Cement 9 Other (specify below) Welded .....  
**2** PVC 4 ABS 7 Fiberglass ..... Threaded.

Blank casing diameter ..... **2** ..... in. to ..... **5** ..... ft., Dia ..... in. to ..... ft., Dia ..... in. to ..... ft.  
 Casing height above land surface ..... **28.32** ..... in., weight ..... lbs./ft. Wall thickness or gauge No. .... **Sch. 40** .....

TYPE OF SCREEN OR PERFORATION MATERIAL **7** PVC 10 Asbestos-cement  
 1 Steel 3 Stainless steel 5 Fiberglass 8 RMP (SR) 11 Other (specify) .....  
 2 Brass 4 Galvanized steel 6 Concrete tile 9 ABS 12 None used (open hole)

SCREEN OR PERFORATION OPENINGS ARE: 5 Gauzed wrapped 8 Saw cut 11 None (open hole)  
**1** Continuous slot 3 Mill slot 6 Wire wrapped 9 Drilled holes  
 2 Louvered shutter 4 Key punched 7 Torch cut 10 Other (specify) .....

SCREEN-PERFORATED INTERVALS: From ..... **5** ..... ft. to ..... **20** ..... ft., From ..... ft. to ..... ft.  
 From ..... ft. to ..... ft., From ..... ft. to ..... ft.  
 GRAVEL PACK INTERVALS: From ..... **4.5** ..... ft. to ..... **28.7** ..... ft., From ..... ft. to ..... ft.  
 From ..... ft. to ..... ft., From ..... ft. to ..... ft.

6 GROUT MATERIAL: 1 Neat cement **2** Cement grout **3** Bentonite 4 Other .....  
 Grout Intervals: From ..... **0** ..... ft. to ..... **1** ..... ft., From ..... **1** ..... ft. to ..... **4.5** ..... ft., From ..... ft. to ..... ft.

What is the nearest source of possible contamination:  
 1 Septic tank 4 Lateral lines 7 Pit privy 10 Livestock pens 14 Abandoned water well  
 2 Sewer lines 5 Cess pool 8 Sewage lagoon 11 Fuel storage 15 Oil well/Gas well  
 3 Watertight sewer lines 6 Seepage pit 9 Feedyard 12 Fertilizer storage **16** Other (specify below)  
 3 Watertight sewer lines 6 Seepage pit 9 Feedyard 13 Insecticide storage **Refinery Facility** .....

Direction from well? **At Refinery** How many feet?

FROM	TO	LITHOLOGIC LOG	FROM	TO	PLUGGING INTERVALS
0	0.5	Clay, Dark Brown			
0.5	2.5	Gravel,			
2.5	4	Sand, Dark Brown to Black			
4	7	Silt, Dark Brown			
7	11.5	Clay, Olive			
11.5	14	Clay, Dark Olive Gray			
14	15	Clay, Gray			
15	19	Clay, Olive Gray			
19	20	Clay, Olive			
20	25.5	Silt, Pale Olive			
25.5	27	Sand, Dark Yellow Brown			
27	27.25	Clay, Brown			
27.25	28.25	Gravel, Olive			RMW136, Abovegrade
28.25	28.7	Limestone, Pale Olive			Project Name: Farmland Refinery-56 Wells
					GeoCore # 255

7 CONTRACTOR'S OR LANDOWNER'S CERTIFICATION: This water well was **1** constructed, (2) reconstructed, or (3) plugged under my jurisdiction and was completed on (mo/day/year) ..... **12/19/95** ..... and this record is true to the best of my knowledge and belief.  
 Kansas Water Well Contractor's License No. .... **527** ..... This Water Well Record was completed on (mo/day/yr) ..... **12/27/95** .....  
 under the business name of **GeoCore Services, Inc.** by (signature) *Paul Kohl*