


1 LOCATION OF WATER WELL: Fraction SE 1/4 SW 1/4 SE 1/4 Section Number 25 Township Number T 34 S Range Number R 16 E/W

Distance and direction from nearest town or city street address of well if located within city? 400 N. Linden, Coffeyville, KS

2 WATER WELL OWNER: Farmland Industries, Inc. RR#, St. Address, Box #: P.O. Box 570 City, State, ZIP Code: Coffeyville, Kansas 67337-0570 Board of Agriculture, Division of Water Resources Application Number:

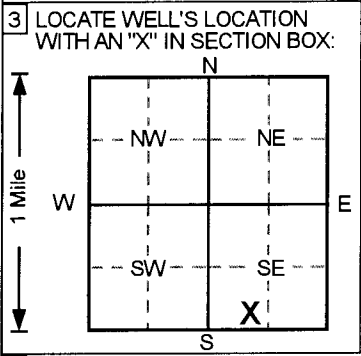

4 DEPTH OF COMPLETED WELL 13 ft. ELEVATION: 720.75 Depth(s) Groundwater Encountered 1. 8.3 ft. 2. ft. 3. ft. WELL'S STATIC WATER LEVEL ft. below land surface measured on mo/day/yr Pump test data: Well water was NA ft. after hours pumping Est. Yield NA gpm: Well water was ft. after hours pumping Bore Hole Diameter 8 in. to 19 ft., and in. to ft. WELL WATER TO BE USED AS: 5 Public water supply 8 Air conditioning 11 Injection well 1 Domestic 3 Feedlot 6 Oil field water supply 9 Dewatering 12 Other (Specify below) 2 Irrigation 4 Industrial 7 Lawn and garden only 10 Monitoring well Was a chemical/bacteriological sample submitted to Department? Yes No If yes, mo/day/yr sample was submitted Water Well Disinfected? Yes No

5 TYPE OF BLANK CASING USED: 1 Steel 2 PVC 3 RMP (SR) 4 ABS 5 Wrought iron 6 Asbestos-Cement 7 Fiberglass 8 Concrete tile 9 Other (specify below) CASING JOINTS: Glued Clamped Welded Threaded Blank casing diameter 2 in. to 3 ft., Dia in. to ft., Dia in. to ft. Casing height above land surface 13.2 in., weight lbs./ft. Wall thickness or gauge No. Sch. 40 TYPE OF SCREEN OR PERFORATION MATERIAL: 1 Steel 2 Brass 3 Stainless steel 4 Galvanized steel 5 Fiberglass 6 Concrete tile 7 PVC 8 RMP (SR) 9 ABS 10 Asbestos-cement 11 Other (specify) 12 None used (open hole) SCREEN OR PERFORATION OPENINGS ARE: 1 Continuous slot 2 Louvered shutter 3 Mill slot 4 Key punched 5 Gauzed wrapped 6 Wire wrapped 7 Torch cut 8 Saw cut 9 Drilled holes 10 Other (specify) 11 None (open hole) SCREEN-PERFORATED INTERVALS: From 3 ft. to 13 ft., From ft. to ft. From ft. to ft. From ft. to ft. GRAVEL PACK INTERVALS: From 2.5 ft. to 19 ft., From ft. to ft. From ft. to ft. From ft. to ft.

6 GROUT MATERIAL: 1 Neat cement 2 Cement grout 3 Bentonite 4 Other Grout intervals: From 0 ft. to 1 ft., From 1 ft. to 2.5 ft., From ft. to ft. What is the nearest source of possible contamination: 1 Septic tank 2 Sewer lines 3 Watertight sewer lines 4 Lateral lines 5 Cess pool 6 Seepage pit 7 Pit privy 8 Sewage lagoon 9 Feedyard 10 Livestock pens 11 Fuel storage 12 Fertilizer storage 13 Insecticide storage 14 Abandoned water well 15 Oil well/Gas well 16 Other (specify below) Refinery Facility Direction from well? At Refinery How many feet?

Table with 6 columns: FROM, TO, LITHOLOGIC LOG, FROM, TO, PLUGGING INTERVALS. Data rows: 0-1.5 Gravel, 1.5-5.5 Clay, Olive Gray, 5.5-12 Clay, Olive Gray, 12-18.5 Silt, Olive Gray, 18.5-19 Limestone, Olive. Additional rows for MW28, Abovegrade; Project Name: Farmland Refinery-56 Wells; GeoCore # 255.

7 CONTRACTOR'S OR LANDOWNER'S CERTIFICATION: This water well was (1) constructed, (2) reconstructed, or (3) plugged under my jurisdiction and was completed on (mo/day/year) 12/18/95 and this record is true to the best of my knowledge and belief. Kansas Water Well Contractor's License No. 527. This Water Well Record was completed on (mo/day/yr) 12/27/95 under the business name of GeoCore Services, Inc. by (signature) Dan Rehl

OFFICE USE ONLY T R EWM SEC