


1 LOCATION OF WATER WELL: Fraction NW 1/4 NW 1/4 SE 1/4 Section Number 25 Township Number T 34 S Range Number R 16 EW

Distance and direction from nearest town or city street address of well if located within city? 400 N. Linden, Coffeyville, KS

2 WATER WELL OWNER: Farmland Industries, Inc. RR#, St. Address, Box # : P.O. Box 570 City, State, ZIP Code : Coffeyville, Kansas 67337-0570 Board of Agriculture, Division of Water Resources Application Number:

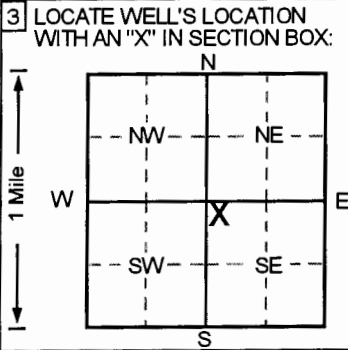

3 LOCATE WELL'S LOCATION WITH AN "X" IN SECTION BOX: 4 DEPTH OF COMPLETED WELL 30.5 ft. ELEVATION: 710.98. WELL'S STATIC WATER LEVEL ft. below land surface measured on mo/day/yr. Pump test data: Well water was NA . . . ft. after . . . hours pumping gpm. Est. Yield . . . NA . . . gpm: Well water was . . . ft. after . . . hours pumping gpm. Bore Hole Diameter . . . 8 . . . in. to . . . 30.5 . . . ft., and . . . in. to . . . ft. WELL WATER TO BE USED AS: 5 Public water supply 8 Air conditioning 11 Injection well 1 Domestic 3 Feedlot 6 Oil field water supply 9 Dewatering 12 Other (Specify below) 2 Irrigation 4 Industrial 7 Lawn and garden only 10 Monitoring well. Was a chemical/bacteriological sample submitted to Department? Yes.....No [X].....; If yes, mo/day/yr sample was submitted. Water Well Disinfected? Yes No [X]

5 TYPE OF BLANK CASING USED: 1 Steel 2 PVC 3 RMP (SR) 4 ABS 5 Wrought iron 6 Asbestos-Cement 7 Fiberglass 8 Concrete tile 9 Other (specify below) CASING JOINTS: Glued Clamped Welded Threaded. [X]. Blank casing diameter 2 in. to 25.5 ft., Dia in. to ft., Dia in. to ft. Casing height above land surface 34.2 in., weight lbs./ft. Wall thickness or gauge No. . . . Sch. 40. TYPE OF SCREEN OR PERFORATION MATERIAL: 1 Steel 2 Brass 3 Stainless steel 4 Galvanized steel 5 Fiberglass 6 Concrete tile 7 PVC 8 RMP (SR) 9 ABS 10 Asbestos-cement 11 Other (specify) 12 None used (open hole). SCREEN OR PERFORATION OPENINGS ARE: 1 Continuous slot 2 Louvered shutter 3 Mill slot 4 Key punched 5 Gauzed wrapped 6 Wire wrapped 7 Torch cut 8 Saw cut 9 Drilled holes 10 Other (specify) 11 None (open hole). SCREEN-PERFORATED INTERVALS: From 25.5 ft. to 30.5 ft., From ft. to ft. GRAVEL PACK INTERVALS: From 21.5 ft. to 30.5 ft., From ft. to ft.

6 GROUT MATERIAL: 1 Neat cement 2 Cement grout 3 Bentonite 4 Other. Grout Intervals: From 0 ft. to 1.5 ft., From 1.5 ft. to 21.5 ft., From ft. to ft. What is the nearest source of possible contamination: 1 Septic tank 2 Sewer lines 3 Watertight sewer lines 4 Lateral lines 5 Cess pool 6 Seepage pit 7 Pit privy 8 Sewage lagoon 9 Feedyard 10 Livestock pens 11 Fuel storage 12 Fertilizer storage 13 Insecticide storage 14 Abandoned water well 15 Oil well/Gas well 16 Other (specify below) Refinery Facility. Direction from well? At Refinery. How many feet?

Table with columns: FROM, TO, LITHOLOGIC LOG, FROM, TO, PLUGGING INTERVALS. Rows show geological layers: Clay, Dark Yellow Brown; Silt, Dark Yellow Brown; Silt, Olive; Clay, Dark Gray; Sand, Olive; Limestone, White. Includes RMW207, Tag #, Abovegrade; Project Name: Farmland Refinery-56 Wells; GeoCore # 255, #

7 CONTRACTOR'S OR LANDOWNER'S CERTIFICATION: This water well was (1) constructed, (2) reconstructed, or (3) plugged under my jurisdiction and was completed on (mo/day/year) 4/30/96 and this record is true to the best of my knowledge and belief. Kansas Water Well Contractor's License No. 527 This Water Well Record was completed on (mo/day/yr) 5/30/96 under the business name of GeoCore Services, Inc. by (signature) Dale Bell

INSTRUCTIONS: Use typewriter or ball point pen. PLEASE PRESS FIRMLY and PRINT clearly. Please fill in blanks, underline or circle the correct answers. Send top three copies to Kansas Department of Health and Environment, Bureau of Water, Topeka, Kansas 66620-0001. Telephone: 913-296-5545. Send one to WATER WELL OWNER and retain one for your records.

OFFICE USE ONLY T R EWM SEC. 1/4 1/4 1/4