

1 LOCATION OF WATER WELL: County: Montgomery Fraction: NE 1/4 SE 1/4 NW 1/4 Section Number: 33 Township Number: T 34 S Range Number: R 16 EW

Distance and direction from nearest town or city street address of well if located within city?

3800 Asbury Drive Coffeyville KS.

2 WATER WELL OWNER: Pioneer Industrial Services


RR#, St. Address, Box #: P.O. Box 1452 Bartlesville OK. 74005

Board of Agriculture, Division of Water Resources

Application Number:

3 LOCATE WELL'S LOCATION WITH AN "X" IN SECTION BOX:

4 DEPTH OF COMPLETED WELL: _____ ft. ELEVATION: _____ ft.

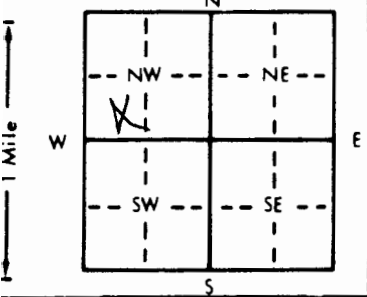

Depth(s) Groundwater Encountered: 0 ft. 2. _____ ft. 3. _____ ft.

WELL'S STATIC WATER LEVEL: 0 ft. below land surface measured on mo/day/yr

Pump test data: Well water was _____ ft. after _____ hours pumping _____ gpm

Est. Yield _____ gpm: Well water was _____ ft. after _____ hours pumping _____ gpm

Bore Hole Diameter: 5 in. to 18 ft., and _____ in. to _____ ft.

WELL WATER TO BE USED AS:

5 Public water supply	8 Air conditioning	11 Injection well
1 Domestic	3 Feedlot	6 Oil field water supply
2 Irrigation	4 Industrial	7 Lawn and garden only
		9 Dewatering
		10 Monitoring well
		12 Other (Specify below) <u>B-3</u>

Was a chemical/bacteriological sample submitted to Department? Yes _____ No X If yes, mo/day/yr sample was submitted _____

Water Well Disinfected? Yes _____ No X

5 TYPE OF BLANK CASING USED:

1 Steel	3 RMP (SR)	5 Wrought iron	8 Concrete tile	CASING JOINTS: Glued _____ Clamped _____
2 PVC	4 ABS	6 Asbestos-Cement	9 Other (specify below)	Welded _____
7 Fiberglass				Threaded <u>X</u>

Blank casing diameter: 2 in. to 2 ft., Dia _____ in. to _____ ft., Dia _____ in. to _____ ft.

Casing height above land surface: 24 in., weight _____ lbs./ft. Wall thickness or gauge No. _____

TYPE OF SCREEN OR PERFORATION MATERIAL:

1 Steel	3 Stainless steel	5 Fiberglass	8 RMP (SR)	10 Asbestos-cement
2 Brass	4 Galvanized steel	6 Concrete tile	9 ABS	11 Other (specify) _____
				12 None used (open hole)

SCREEN OR PERFORATION OPENINGS ARE:

1 Continuous slot	3 Mill slot	5 Gauzed wrapped	8 Saw cut	11 None (open hole)
2 Louvered shutter	4 Key punched	6 Wire wrapped	9 Drilled holes	
		7 Torch cut	10 Other (specify) _____	

SCREEN-PERFORATED INTERVALS: From 17 ft. to 2 ft., From _____ ft. to _____ ft.

GRAVEL PACK INTERVALS: From 18 ft. to 15 ft., From _____ ft. to _____ ft.

6 GROUT MATERIAL: 1 Neat cement 2 Cement grout 3 Bentonite 4 Other _____

GROUT INTERVALS: From 0.0 ft. to 5 ft., From _____ ft. to _____ ft.

What is the nearest source of possible contamination:

1 Septic tank	4 Lateral lines	7 Pit privy	10 Livestock pens	14 Abandoned water well
2 Sewer lines	5 Cess pool	8 Sewage lagoon	11 Fuel storage	15 Oil well/Gas well
3 Watertight sewer lines	6 Seepage pit	9 Feedyard	12 Fertilizer storage	16 Other (specify below)
			13 Insecticide storage	

Direction from well? _____ How many feet? _____

FROM	TO	LITHOLOGIC LOG	FROM	TO	PLUGGING INTERVALS
0.0	1.0	Silt: Dark Brown	18.0	1.0	20-40 Silica SAND
1.0	3.5	Silty clay: Light Brown	1.0	0.0	Silty clay
3.5	4.0	Limestone: White & Gray			(Pulled 2" casing & screen)
4.0	6.5	Weathered shale: Tan			
6.5	8.5	Limestone: Gray			
8.5	18.0	Siltstone: Gray			

CONTRACTOR'S OR LANDOWNER'S CERTIFICATION: This water well was (1) constructed, (2) reconstructed, or (3) plugged under my jurisdiction and was completed on (mo/day/year) 12-27-96 and this record is true to the best of my knowledge and belief. Kansas Water Well Contractor's License No. 605 This Water Well Record was completed on (mo/day/yr) 1-7-97 under the business name of Cherokee America Drilling by (signature) Jim Tyler