


WATER WELL RECORD Form WWC-5 KSA 82a-1212

1 LOCATION OF WATER WELL: County: Montgomery Fraction SE ¼ SW ¼ SE ¼ Section Number 25 Township Number T 34 S Range Number R 16 EW

Distance and direction from nearest town or city street address of well if located within city? 400 N. Linden, Coffeyville, Kansas

2 WATER WELL OWNER: Farmland Industries, Inc. RR#, St. Address, Box# : P.O. Box 570 Board of Agriculture, Division of Water Resources City, State, ZIP Code : Coffeyville, Kansas 67337-0570 Application Number:

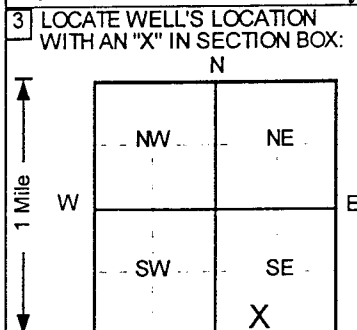

3 LOCATE WELL'S LOCATION WITH AN 'X' IN SECTION BOX: 4 DEPTH OF COMPLETED WELL: 26 ft ELEVATION: 716.93 Depth(s) Groundwater Encountered 1. 999 ft 2. ft 3. ft WELL'S STATIC WATER LEVEL: .999 ft below land surface measured on mo/day/yr Pump test data: Well water was NA ft after hours pumping gpm Est. Yield NA gpm: Well water was ft after hours pumping gpm Bore Hole Diameter 8 in. to .26 ft, and in. to ft WELL WATER TO BE USED AS: 5 Public water supply 8 Air conditioning 11 Injection well 1 Domestic 3 Feedlot 6 Oil field water supply 9 Dewatering 12 Other (Specify below) 2 Irrigation 4 Industrial 7 Lawn and garden only 10 Monitoring well Was a chemical/bacteriological sample submitted to Department? Yes No; If yes, mo/day/yr sample was submitted Water Well Disinfected? Yes No

5 TYPE OF BLANK CASING USED: 1 Steel 3 RMP (SR) 5 Wrought iron 8 Concrete tile CASING JOINTS: Glued Clamped Welded Threaded 2 PVC 4 ABS 7 Fiberglass 9 Other (specify below)

Blank casing diameter 2 in. to 11 ft, Dia in. to ft, Dia in. to ft Casing height above land surface 35.04 in., weight Sch 40 lbs./ft. Wall thickness or gauge No.

TYPE OF SCREEN OR PERFORATION MATERIAL: 1 Steel 3 Stainless steel 5 Fiberglass 7 RMP (SR) 10 Asbestos-cement 2 Brass 4 Galvanized steel 6 Concrete tile 9 ABS 11 Other (specify) 12 None used (open hole)

SCREEN OR PERFORATION OPENINGS ARE: 1 Continuous slot 3 Mill slot 5 Gauzed wrapped 8 Saw cut 11 None (open hole) 2 Louvered shutter 4 Key punched 6 Wire wrapped 9 Drilled holes 7 Torch cut 10 Other (specify)

SCREEN-PERFORATED INTERVALS: From 11 ft to 25.5 ft, From ft to ft, From ft to ft GRAVEL PACK INTERVALS: From 8 ft to 26 ft, From ft to ft, From ft to ft

6 GROUT MATERIAL: 1 Neat cement 2 Cement grout 3 Bentonite 4 Other Grout Intervals: From 0 ft to 1 ft, From 1 ft to 8 ft, From ft to ft

What is the nearest source of possible contamination: 1 Septic tank 4 Lateral lines 7 Pit privy 10 Livestock pens 14 Abandoned water well 2 Sewer lines 5 Cess pool 8 Sewage lagoon 11 Fuel storage 15 Oil well/Gas well 3 Watertight sewer lines 6 Seepage pit 9 Feedyard 12 Fertilizer storage 16 Other (specify below) Refinery 13 Insecticide storage How many feet? 0

Table with columns: FROM, TO, LITHOLOGIC LOG, FROM, TO, PLUGGING INTERVALS. Rows describe geological layers: Clayey Silt, Silty Clay, Clay, Silty Clay, Sand, Gravel.

7 CONTRACTOR'S OR LANDOWNER'S CERTIFICATION: This water well was (1) constructed, (2) reconstructed, or (3) plugged under my jurisdiction and was completed on (mo/day/year) 7/21/97 and this record is true to the best of my knowledge and belief. Kansas Water Well Contractor's License No. 527 This Water Well Record was completed on (mo/day/yr) 8/19/97 under the business name of GeoCore Services, Inc. by (signature) Dale Robl

INSTRUCTIONS: Use typewriter or ball point pen. PLEASE PRESS FIRMLY and PRINT clearly. Please fill in blanks, underline or circle the correct answers. Send top three copies to Kansas Department of Health and Environment, Bureau of Water, Topeka, Kansas 66620-0001. Telephone: 913-296-5545. Send one to WATER WELL OWNER and retain one for your records.