


1] LOCATION OF WATER WELL: County: **MONTGOMERY** Fraction: **NE 1/4 SE 1/4 NE 1/4** Section Number: **36** Township Number: **T 34 S** Range Number: **R 16 E**

Distance and direction from nearest town or city street address of well if located within city?
SUNFLOWER ST + E NORTH ST

2] WATER WELL OWNER: **COFFEYVILLE RESOURCES NITRIGEN** MW-3
 RR#, St. Address, Box #: **400 N. LINDEN** Board of Agriculture, Division of Water Resources
 City, State, ZIP Code: **COFFEYVILLE, KS 67337** Application Number:

3] LOCATE WELL'S LOCATION WITH AN "X" IN SECTION BOX:

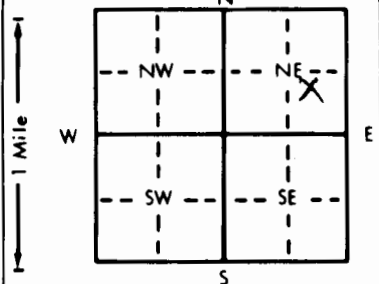

4] DEPTH OF COMPLETED WELL: **15** ft. ELEVATION:
 Depth(s) Groundwater Encountered 1. **8** ft. 2. ft. 3. ft.
 WELL'S STATIC WATER LEVEL: ft. below land surface measured on mo/day/yr **July 05**
 Pump test data: Well water was ft. after hours pumping gpm
 Est. Yield gpm: Well water was ft. after hours pumping gpm
 Bore Hole Diameter: **2** in. to **1.5** ft., and in. to ft.
 WELL WATER TO BE USED AS:
 1 Domestic 3 Feedlot 6 Oil field water supply 9 Dewatering 12 Other (Specify below)
 2 Irrigation 4 Industrial 7 Lawn and garden only Monitoring well
 Was a chemical/bacteriological sample submitted to Department? Yes No ; If yes, mo/day/yr sample was submitted
 Water Well Disinfected? Yes No

5] TYPE OF BLANK CASING USED:
 1 Steel 3 RMP (SR) 5 Wrought iron 8 Concrete tile CASING JOINTS: Glued Clamped
 PVC 4 ABS 7 Fiberglass 9 Other (specify below) Welded
 Blank casing diameter: **1** in. to **1.5** ft., Dia. in. to ft., Dia. in. to ft.
 Casing height above land surface: **3** in., weight **STEEL CASING** lbs./ft. Wall thickness or gauge No.
 TYPE OF SCREEN OR PERFORATION MATERIAL:
 1 Steel 3 Stainless steel 5 Fiberglass 8 RMP (SR) 10 Asbestos-cement
 2 Brass 4 Galvanized steel 6 Concrete tile 9 ABS 12 None used (open hole)
 SCREEN OR PERFORATION OPENINGS ARE:
 Continuous slot 3 Mill slot 5 Gauzed wrapped 8 Saw cut 11 None (open hole)
 2 Louvered shutter 4 Key punched 6 Wire wrapped 9 Drilled holes
 SCREEN-PERFORATED INTERVALS: From **5** ft. to **1.5** ft., From ft. to ft.
 GRAVEL PACK INTERVALS: From **3** ft. to **1.5** ft., From ft. to ft.

6] GROUT MATERIAL: 1 Neat cement 2 Cement grout Bentonite 4 Other
 Grout Intervals: From **0** ft. to **3** ft., From ft. to ft., From ft. to ft.
 What is the nearest source of possible contamination:
 1 Septic tank 4 Lateral lines 7 Pit privy 10 Livestock pens 14 Abandoned water well
 2 Sewer lines 5 Cess pool 8 Sewage lagoon Fertilizer storage 15 Oil well/Gas well
 3 Watertight sewer lines 6 Seepage pit 9 Feedyard 13 Insecticide storage 16 Other (specify below)
 Direction from well? **W** How many feet? **250**

FROM	TO	LITHOLOGIC LOG	FROM	TO	PLUGGING INTERVALS
0	8	CLAY			
8	15	SILT, CLAY SAND			
		WAIVER FOR 1" CASING PER DON TAYLOR			

7] CONTRACTOR'S OR LANDOWNER'S CERTIFICATION: This water well was (1) constructed, (2) reconstructed, or (3) plugged under my jurisdiction and was completed on (mo/day/year) **10 July 05** and this record is true to the best of my knowledge and belief. Kansas Water Well Contractor's License No. **693** This Water Well Record was completed on (mo/day/yr) **10 Aug 05** under the business name of **DETECT, INC** by (signature) *[Signature]*

OFFICE USE ONLY

T

R

EW

SEC

1/4

1/4

1/4