


1 LOCATION OF WATER WELL: Fraction SW SW SW Section Number 32 Township Number N 34 Range Number 16 EN  
 County: Montgomery

Distance and direction from nearest town or city street address of well if located within city?  
Tanglewood & 1st Street Coffeyville KS

2 WATER WELL OWNER: Williams Companies  
 RR #, St. Address, Box #: one Williams Center MO48-6 Board of Agriculture, Division of Water Resources  
 City, State, ZIP Code: TULSA OKLA 74172 Application Number:

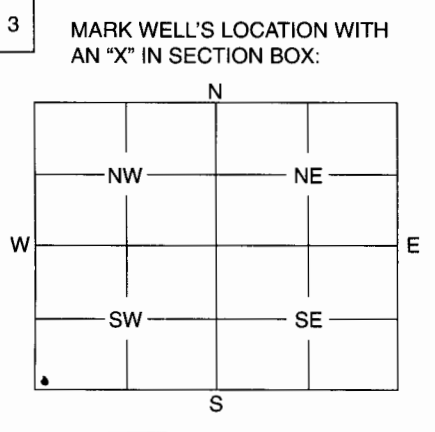

4 DEPTH OF WELL 9.7 ft.  
 WELL'S STATIC WATER LEVEL ..... ft.  
 WELL WAS USED AS:  
 1 Domestic 5 Public Water Supply 9 Dewatering  
 2 Irrigation 6 Oil Field Water Supply 10 Monitoring Well  
 3 Feedlot 7 Domestic (Lawn & Garden) 11 Injection Well  
 4 Industrial 8 Air Conditioning 12 Other .....

Was a chemical / bacteriological sample submitted to Department? Yes ..... No .....  
 If yes, mo/day/yr sample was submitted .....

Water Well Disinfected: Yes ..... No .....

5 TYPE OF BLANK CASING USED:  
 1 Steel 3 RMP (SR) 5 Wrought 7 Fiberglass 9 Other (Specify below)  
 2 PVC 4 ABS 6 Asbestos-Cement 8 Concrete Tile .....

Blank casing diameter ..... in. Was casing pulled? Yes X No ..... If yes, how much All .....

Casing height above or below land surface ..... in.

6 GROUT PLUG MATERIAL: 1 Neat cement 2 Cement grout 3 Bentonite 4 Other .....

Grout Plug Intervals: From ..... ft. to ..... ft., From ..... ft. to ..... ft., From ..... to .....

What is the nearest source of possible contamination:  
 1 Septic tank 6 Seepage pit 11 Fuel storage 16 Other (specify below)  
 2 Sewer lines 7 Pit privy 12 Fertilizer storage .....

3 Watertight sewer lines 8 Sewage lagoon 13 Insecticide storage .....

4 Lateral lines 9 Feedyard 14 Abandoned water well .....

5 Cess pool 10 Livestock pens 15 Oil well/Gas well .....

Direction from well? ..... How many feet? .....

FROM	TO	PLUGGING MATERIALS
<u>9.7</u>	<u>Q</u>	<u>Portland Cement</u>

7 CONTRACTOR'S OF LANDOWNER'S CERTIFICATION: This water well was plugged under my jurisdiction and was completed on (mo/day/year) 8/24/05 and this record is true to the best of my knowledge and belief. Kansas Water Well Contractor's License No. 605 This Water Well Record was completed on (mo/day/year) ..... under the business name of Clearer America Drilling by (signature) Sten Wolf

INSTRUCTIONS: Use typewriter or ball point pen. Please press firmly and print clearly. Please fill in blanks, underline or circle the correct answers. Send top three copies to Kansas Department of Health and Environment, Bureau of Water, Geology Section, 1000 SW Jackson St., Ste. 420, Topeka, Kansas 66612-1367. Telephone: 785/296-5522. Send one to Water Well Owner and retain one for your records.