

**CORRECTION(S) TO WATER WELL RECORD (WWC-5)**

(to rectify lacking or incorrect information)

**Location listed as:**

Section-Township-Range: 33-134-16E

Fraction (  $\frac{1}{4}$   $\frac{1}{4}$   $\frac{1}{4}$  ): NW

County: Montgomery

**Location changed to:**

33-34S-16E

SW SW NW

**Other changes:** Initial statements: \_\_\_\_\_

Changed to: \_\_\_\_\_

Comments: \_\_\_\_\_

verification method: Written & legal descriptions, original construction record for this well, and Coffeyville West 1:24,000 topo. map.


initials: DRD date: 11/1/2005

submitted by: Kansas Geological Survey, Data Resources Library, 1930 Constant Ave., Lawrence, KS 66047-3726  
to: Kansas Dept of Health & Environment, Bureau of Water, 1000 SW Jackson, Suite 420, Topeka, KS 66612-1367.

1 LOCATION OF WATER WELL: Fraction NW Section Number 33 Township Number N 34 Range Number 16 EW  
 County: Montgomery

Distance and direction from nearest town or city street address of well if located within city?  
Inglewood & 1st Street Coffeyville KS

2 WATER WELL OWNER: The Williams Co.  
 RR #, St. Address, Box #: one William Center MO 48-C Board of Agriculture, Division of Water Resources  
 City, State, ZIP Code: TULSA OK 74172 Application Number:

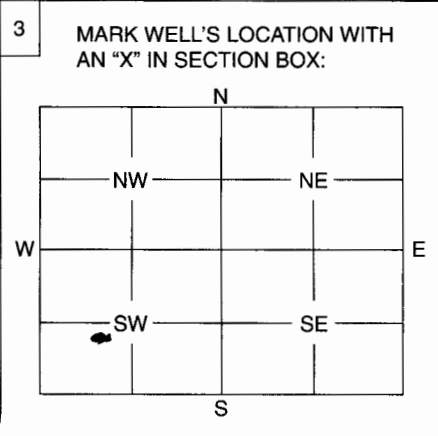

4 DEPTH OF WELL 13.80 ft.  
 WELL'S STATIC WATER LEVEL ..... ft.  
 WELL WAS USED AS:  
 1 Domestic                      5 Public Water Supply                      9 Dewatering  
 2 Irrigation                      6 Oil Field Water Supply                      10 Monitoring Well  
 3 Feedlot                      7 Domestic (Lawn & Garden)                      11 Injection Well  
 4 Industrial                      8 Air Conditioning                      12 Other .....

Was a chemical / bacteriological sample submitted to Department? Yes ..... No .....  
 If yes, mo/day/yr sample was submitted .....

Water Well Disinfected: Yes ..... No .....

5 TYPE OF BLANK CASING USED:  
 1 Steel                      3 RMP (SR)                      5 Wrought                      7 Fiberglass                      9 Other (Specify below)  
 2 PVC                      4 ABS                      6 Asbestos-Cement                      8 Concrete Tile

Blank casing diameter ..... in.                      Was casing pulled? Yes X No .....                      If yes, how much All

Casing height above or below land surface ..... in.

6 GROUT PLUG MATERIAL: 1 Neat cement                      2 Cement grout                      3 Bentonite                      4 Other .....

Grout Plug Intervals: From ..... ft. to ..... ft., From ..... ft. to ..... ft., From ..... to ..... ft.

What is the nearest source of possible contamination:  
 1 Septic tank                      6 Seepage pit                      11 Fuel storage                      16 Other (specify below)  
 2 Sewer lines                      7 Pit privy                      12 Fertilizer storage  
 3 Watertight sewer lines                      8 Sewage lagoon                      13 Insecticide storage  
 4 Lateral lines                      9 Feedyard                      14 Abandoned water well  
 5 Cess pool                      10 Livestock pens                      15 Oil well/Gas well

Direction from well? .....                      How many feet? .....

FROM	TO	PLUGGING MATERIALS
<u>13.80</u>	<u>5</u>	<u>Portland Cement</u>

7 CONTRACTOR'S OF LANDOWNER'S CERTIFICATION: This water well was plugged under my jurisdiction and was completed on (mo/day/year) 8/26/2005 and this record is true to the best of my knowledge and belief. Kansas Water Well Contractor's License No. 605 This Water Well Record was completed on (mo/day/year) .....  
 by (signature) Charles America Dally

INSTRUCTIONS: Use typewriter or ball point pen. Please press firmly and print clearly. Please fill in blanks, underline or circle the correct answers. Send top three copies to Kansas Department of Health and Environment, Bureau of Water, Geology Section, 1000 SW Jackson St., Ste. 420, Topeka, Kansas 66612-1367. Telephone: 785/296-5522. Send one to Water Well Owner and retain one for your records.