

**CORRECTION(S) TO WATER WELL RECORD (WWC-5)**

(to rectify lacking or incorrect information)

**Location listed as:**

Section-Township-Range: 33-1134-16E

Fraction ( 1/4 1/4 1/4): NW

County: Montgomery

**Location changed to:**

33-345-16E

SW SW NW

**Other changes:** Initial statements: \_\_\_\_\_

Changed to: \_\_\_\_\_

Comments: \_\_\_\_\_

verification method: Written & legal descriptions, locations of other monitoring wells in this series, and Coffeyville West 1:24,000 topo. map. initials: DRJ date: 11/1/2005


submitted by: Kansas Geological Survey, Data Resources Library, 1930 Constant Ave., Lawrence, KS 66047-3726

to: Kansas Dept of Health & Environment, Bureau of Water, 1000 SW Jackson, Suite 420, Topeka, KS 66612-1367.

|   |                           |                                       |           |        |          |           |           |           |
|---|---------------------------|---------------------------------------|-----------|--------|----------|-----------|-----------|-----------|
| 1 | LOCATION OF WATER WELL:   | Fraction                              | Section   | Number | Township | Number    | Range     | Number    |
|   | County: <u>Montgomery</u> | $\frac{1}{4}$ $\frac{1}{4}$ <u>NW</u> | <u>33</u> |        | <u>N</u> | <u>34</u> | <u>16</u> | <u>EW</u> |

Distance and direction from nearest town or city street address of well if located within city?  
Single Wood #1st Street Coffeyville KS

|   |  |
|---|--|
| 2 | WATER WELL OWNER: <u>The William Co</u>  |
|   | RR #, St. Address, Box #: <u>one Williams Center MO-48-6</u> Board of Agriculture, Division of Water Resources |
|   | City, State, ZIP Code: <u>Tulsa OK 74132</u> Application Number:   |

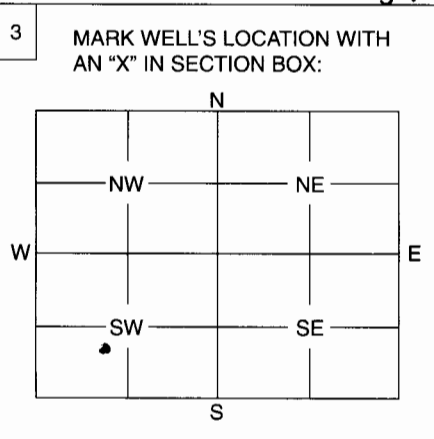

4 DEPTH OF WELL 13.80 ft.

WELL'S STATIC WATER LEVEL ..... ft.

WELL WAS USED AS:

|              |                            |                    |
|--------------|----------------------------|--------------------|
| 1 Domestic   | 5 Public Water Supply      | 9 Dewatering       |
| 2 Irrigation | 6 Oil Field Water Supply   | 10 Monitoring Well |
| 3 Feedlot    | 7 Domestic (Lawn & Garden) | 11 Injection Well  |
| 4 Industrial | 8 Air Conditioning         | 12 Other .....     |

Was a chemical / bacteriological sample submitted to Department? Yes ..... No .....

If yes, mo/day/yr sample was submitted .....

Water Well Disinfected: Yes ..... No .....

5 TYPE OF BLANK CASING USED:

|         |            |                   |                 |                         |
|---------|------------|-------------------|-----------------|-------------------------|
| 1 Steel | 3 RMP (SR) | 5 Wrought         | 7 Fiberglass    | 9 Other (Specify below) |
| 2 PVC   | 4 ABS      | 6 Asbestos-Cement | 8 Concrete Tile |                         |

Blank casing diameter ..... in. Was casing pulled? Yes X No ..... If yes, how much All

Casing height above or below land surface ..... in.

6 GROUT PLUG MATERIAL: 1 Neat cement 2 Cement grout 3 Bentonite 4 Other .....

Grout Plug Intervals: From ..... ft. to ..... ft., From ..... ft. to ..... ft., From ..... to ..... ft.

What is the nearest source of possible contamination:

|                          |                   |                         |                          |
|--------------------------|-------------------|-------------------------|--------------------------|
| 1 Septic tank            | 6 Seepage pit     | 11 Fuel storage         | 16 Other (specify below) |
| 2 Sewer lines            | 7 Pit privy       | 12 Fertilizer storage   |                          |
| 3 Watertight sewer lines | 8 Sewage lagoon   | 13 Insecticide storage  |                          |
| 4 Lateral lines          | 9 Feedyard        | 14 Abandoned water well |                          |
| 5 Cess pool              | 10 Livestock pens | 15 Oil well/Gas well    |                          |

Direction from well? ..... How many feet? .....

| FROM         | TO           | PLUGGING MATERIALS    |
|--------------|--------------|-----------------------|
| <u>13.80</u> | <u>&amp;</u> | <u>Prothane Grout</u> |
|              |              |                       |
|              |              |                       |
|              |              |                       |
|              |              |                       |

7 CONTRACTOR'S OF LANDOWNER'S CERTIFICATION: This water well was plugged under my jurisdiction and was completed on (mo/day/year) 8/27/05 and this record is true to the best of my knowledge and belief. Kansas Water Well Contractor's License No. 605 This Water Well Record was completed on (mo/day/year) ..... under the business name of Cherokee America Drilling by (signature) [Signature]

INSTRUCTIONS: Use typewriter or ball point pen. Please press firmly and print clearly. Please fill in blanks, underline or circle the correct answers. Send top three copies to Kansas Department of Health and Environment, Bureau of Water, Geology Section, 1000 SW Jackson St., Ste. 420, Topeka, Kansas 66612-1367. Telephone: 785/296-5522. Send one to Water Well Owner and retain one for your records.