

CORRECTION(S) TO WATER WELL RECORD (WWC-5)

(to rectify lacking or incorrect information)

Location listed as:

Section-Township-Range: 33-34N-16E

Fraction ($\frac{1}{4}$ $\frac{1}{4}$ $\frac{1}{4}$): NW

County: Montgomery

Location changed to:

33-34S-16E

SW SW NW

Other changes: Initial statements: _____

Changed to: _____

Comments: Plat map on form believed to represent NW $\frac{1}{4}$ of sec.

verification method: Written & legal descriptions, position on plat map,

other monitoring wells in same vicinity for same owner, and

Coffeyville West 1:24,000 topo. map. initials: DRJ date: 11/1/2005


submitted by: Kansas Geological Survey, Data Resources Library, 1930 Constant Ave., Lawrence, KS 66047-3726

to: Kansas Dept of Health & Environment, Bureau of Water, 1000 SW Jackson, Suite 420, Topeka, KS 66612-1367.

1	LOCATION OF WATER WELL:	Fraction	Section	Number	Township	Number	Range	Number
	County: <u>Montgomery</u>	$\frac{1}{4}$ $\frac{1}{4}$ <u>N</u> $\frac{1}{4}$	<u>33</u>		<u>N</u>	<u>34</u>	<u>16</u>	<u>EW</u>

Distance and direction from nearest town or city street address of well if located within city?
Inglewood ± 1st Street Coffeyville KS

2 WATER WELL OWNER: The William's Co.
 RR #, St. Address, Box #: One William's Center MO-446 Board of Agriculture, Division of Water Resources
 City, State, ZIP Code: TULSA OK Application Number:

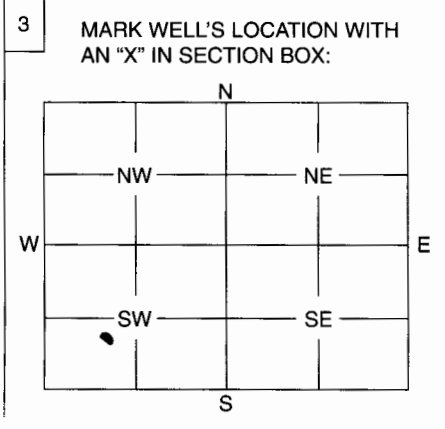

4 DEPTH OF WELL 7.60 ft.
 WELL'S STATIC WATER LEVEL ft.
 WELL WAS USED AS:

1 Domestic	5 Public Water Supply	9 Dewatering
2 Irrigation	6 Oil Field Water Supply	<u>10</u> Monitoring Well
3 Feedlot	7 Domestic (Lawn & Garden)	11 Injection Well
4 Industrial	8 Air Conditioning	12 Other

Was a chemical / bacteriological sample submitted to Department? Yes No
 If yes, mo/day/yr sample was submitted

Water Well Disinfected: Yes No

5 TYPE OF BLANK CASING USED:

1 Steel	3 RMP (SR)	5 Wrought	7 Fiberglass	9 Other (Specify below)
<u>2 PVC</u>	4 ABS	6 Asbestos-Cement	8 Concrete Tile	

Blank casing diameter in. Was casing pulled? Yes X No If yes, how much All

Casing height above or below land surface in.

6 GROUT PLUG MATERIAL: 1 Neat cement 2 Cement grout 3 Bentonite 4 Other

Grout Plug Intervals: From ft. to ft., From ft. to ft., From to ft.

What is the nearest source of possible contamination:

1 Septic tank	6 Seepage pit	11 Fuel storage	16 Other (specify below)
2 Sewer lines	7 Pit privy	12 Fertilizer storage	
3 Watertight sewer lines	8 Sewage lagoon	13 Insecticide storage	
4 Lateral lines	9 Feedyard	14 Abandoned water well	
5 Cess pool	10 Livestock pens	15 Oil well/Gas well	

Direction from well? How many feet?

FROM	TO	PLUGGING MATERIALS
<u>7.60</u>	<u>8</u>	<u>Portland Cement</u>

7 CONTRACTOR'S OR LANDOWNER'S CERTIFICATION: This water well was plugged under my jurisdiction and was completed on (mo/day/year) 8/29/05 and this record is true to the best of my knowledge and belief. Kansas Water Well Contractor's License No. 605- This Water Well Record was completed on (mo/day/year) under the business name of Cherokee America Drilling by (signature) [Signature]

INSTRUCTIONS: Use typewriter or ball point pen. Please press firmly and print clearly. Please fill in blanks, underline or circle the correct answers. Send top three copies to Kansas Department of Health and Environment, Bureau of Water, Geology Section, 1000 SW Jackson St., Ste. 420, Topeka, Kansas 66612-1367. Telephone: 785/296-5522. Send one to Water Well Owner and retain one for your records.