

CORRECTION(S) TO WATER WELL RECORD (WWC-5)

(to rectify lacking or incorrect information)

Location listed as:

Section-Township-Range: 33-N34-16E

Fraction (  $\frac{1}{4}$   $\frac{1}{4}$   $\frac{1}{4}$ ): NW

County: Montgomery

Location changed to:

33-345-16E

SE SW NW

Other changes: Initial statements: \_\_\_\_\_

Changed to: \_\_\_\_\_

Comments: Dot on plat map believed to be location of well within NW quarter.


verification method: Written & legal descriptions, position on plat map, and Coffeyville West 1:24,000 topo. map.

initials: PRD date: 10/31/2005

1 LOCATION OF WATER WELL: Fraction NW Section Number 33 Township Number N 34 Range Number 16  
 County: Montgomery EW

Distance and direction from nearest town or city street address of well if located within city?  
Inglewood & 1st Street Coffeyville KS

2 WATER WELL OWNER: The William's CO  
 RR #, St. Address, Box #: one William's Center MO 486 Board of Agriculture, Division of Water Resources  
 City, State, ZIP Code: Tulsa OK Application Number:

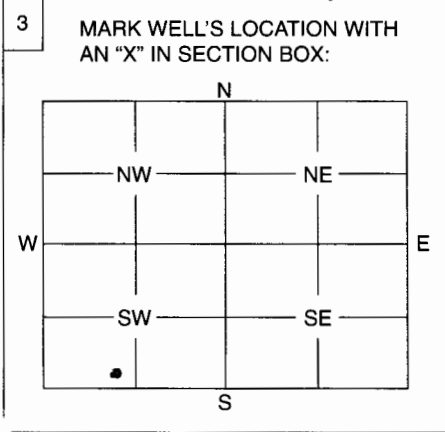

4 DEPTH OF WELL 70 ft.  
 WELL'S STATIC WATER LEVEL ..... ft.  
 WELL WAS USED AS:  
 1 Domestic      5 Public Water Supply      9 Dewatering  
 2 Irrigation      6 Oil Field Water Supply      10 Monitoring Well  
 3 Feedlot      7 Domestic (Lawn & Garden)      11 Injection Well  
 4 Industrial      8 Air Conditioning      12 Other .....  
 Was a chemical / bacteriological sample submitted to Department? Yes ..... No .....  
 If yes, mo/day/yr sample was submitted .....  
 Water Well Disinfected: Yes  No .....

5 TYPE OF BLANK CASING USED:  
 1 Steel       3 RMP (SR)       5 Wrought       7 Fiberglass       9 Other (Specify below)  
 2 PVC       4 ABS       6 Asbestos-Cement       8 Concrete Tile  
 Blank casing diameter ..... in.      Was casing pulled? Yes ..... No .....      If yes, how much .....  
 Casing height above or below land surface ..... in.

6 GROUT PLUG MATERIAL:  1 Neat cement       2 Cement grout       3 Bentonite       4 Other .....  
 Grout Plug Intervals: From ..... ft. to ..... ft., From ..... ft. to ..... ft., From ..... to ..... ft.  
 What is the nearest source of possible contamination:  
 1 Septic tank       6 Seepage pit       11 Fuel storage       16 Other (specify below)  
 2 Sewer lines       7 Pit privy       12 Fertilizer storage  
 3 Watertight sewer lines       8 Sewage lagoon       13 Insecticide storage  
 4 Lateral lines       9 Feedyard       14 Abandoned water well  
 5 Cess pool       10 Livestock pens       15 Oil well/Gas well  
 Direction from well? .....      How many feet? .....

FROM	TO	PLUGGING MATERIALS
<u>70</u>	<u>3</u>	<u>Portland Cement w/ Bentonite</u>

7 CONTRACTOR'S OF LANDOWNER'S CERTIFICATION: This water well was plugged under my jurisdiction and was completed on (mo/day/year) 8/27/05 and this record is true to the best of my knowledge and belief. Kansas Water Well Contractor's License No. 605 This Water Well Record was completed on (mo/day/year) ..... under the business name of Charles America Drilling by (signature) Steve Wolf

INSTRUCTIONS: Use typewriter or ball point pen. Please press firmly and print clearly. Please fill in blanks, underline or circle the correct answers. Send top three copies to Kansas Department of Health and Environment, Bureau of Water, Geology Section, 1000 SW Jackson St., Ste. 420, Topeka, Kansas 66612-1367. Telephone: 785/296-5522. Send one to Water Well Owner and retain one for your records.