

**CORRECTION(S) TO WATER WELL RECORD (WWC-5)**

(to rectify lacking or incorrect information)

County: Montgomery

Location listed as:

Location changed to:

Section-Township-Range: 33-34N-16E

33-34S-16E

Fraction (  $\frac{1}{4}$   $\frac{1}{4}$   $\frac{1}{4}$ ): NW

SW SW NW

Other changes: Initial statements: \_\_\_\_\_

Changed to: \_\_\_\_\_

Comments: Plat map on form believed to represent NW  $\frac{1}{4}$  of sec.


verification method: Written & legal descriptions, position on plat map, other monitoring wells in same vicinity for same owner, and Coffeyville West 1:24,000 topo. map. initials: DRJ date: 11/1/2005

submitted by: Kansas Geological Survey, Data Resources Library, 1930 Constant Ave., Lawrence, KS 66047-3726  
to: Kansas Dept of Health & Environment, Bureau of Water, 1000 SW Jackson, Suite 420, Topeka, KS 66612-1367.

1 LOCATION OF WATER WELL: Fraction 1/4 NW 1/4 Section Number 33 Township Number 34 N Range Number 16 E/W

County: MONTGOMERY  
 Distance and direction from nearest town or city street address of well if located within city?  
Inglewood St 1st Corpeyville KS

2 WATER WELL OWNER: The William's Co.  
 RR #, St. Address, Box #: 1 William's Cir. MD-48-06 Board of Agriculture, Division of Water Resources  
 City, State, ZIP Code: Tulsa, OK 74172 Application Number:

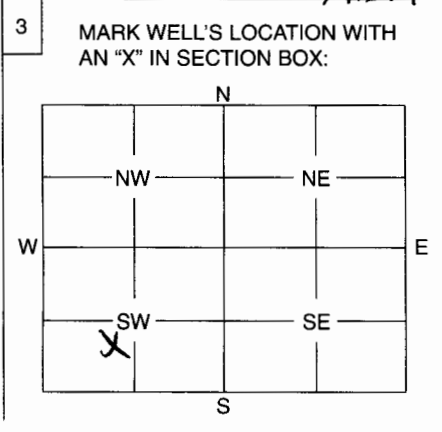

4 DEPTH OF WELL 8.5 ft.  
 WELL'S STATIC WATER LEVEL ..... ft.  
 WELL WAS USED AS:  
 1 Domestic                      5 Public Water Supply                      9 Dewatering  
 2 Irrigation                      6 Oil Field Water Supply                      10 Monitoring Well  
 3 Feedlot                          7 Domestic (Lawn & Garden)                      11 Injection Well  
 4 Industrial                      8 Air Conditioning                          12 Other .....

Was a chemical / bacteriological sample submitted to Department? Yes ..... No .....  
 If yes, mo/day/yr sample was submitted .....

Water Well Disinfected: Yes ..... No .....

5 TYPE OF BLANK CASING USED:  
 1 Steel                      3 RMP (SR)                      5 Wrought                      7 Fiberglass                      9 Other (Specify below)  
 2 PVC                      4 ABS                          6 Asbestos-Cement                      8 Concrete Tile

Blank casing diameter ..... in.                      Was casing pulled? Yes X ..... No .....                      If yes, how much All .....

Casing height above or below land surface ..... in.

6 GROUT PLUG MATERIAL: 1 Neat cement                      2 Cement grout                      3 Bentonite                      4 Other .....

Grout Plug Intervals: From ..... ft. to ..... ft., From ..... ft. to ..... ft., From ..... to ..... ft.

What is the nearest source of possible contamination:  
 1 Septic tank                      6 Seepage pit                      11 Fuel storage                      16 Other (specify below)  
 2 Sewer lines                      7 Pit privy                          12 Fertilizer storage  
 3 Watertight sewer lines                      8 Sewage lagoon                      13 Insecticide storage  
 4 Lateral lines                      9 Feedyard                          14 Abandoned water well  
 5 Cess pool                          10 Livestock pens                      15 Oil well/Gas well

Direction from well? .....                      How many feet? .....

FROM	TO	PLUGGING MATERIALS
<u>8.5</u>	<u>0</u>	<u>Portland Cement</u>

7 CONTRACTOR'S OF LANDOWNER'S CERTIFICATION: This water well was plugged under my jurisdiction and was completed on (mo/day/year) 8/25/05 and this record is true to the best of my knowledge and belief. Kansas Water Well Contractor's License No. 605 This Water Well Record was completed on (mo/day/year) ..... under the business name of Cherokee American Drilling by (signature) [Signature]

INSTRUCTIONS: Use typewriter or ball point pen. Please press firmly and print clearly. Please fill in blanks, underline or circle the correct answers. Send top three copies to Kansas Department of Health and Environment, Bureau of Water, Geology Section, 1000 SW Jackson St., Ste. 420, Topeka, Kansas 66612-1367. Telephone: 785/296-5522. Send one to Water Well Owner and retain one for your records.