

CORRECTION(S) TO WATER WELL RECORD (WWC-5)

(to rectify lacking or incorrect information)

Location listed as:

Section-Township-Range: 33-34N-16E

Fraction ($\frac{1}{4}$ $\frac{1}{4}$ $\frac{1}{4}$): NU

County: Montgomery

Location changed to:

33-34S-16E

SW SW NW

Other changes: Initial statements: _____

Changed to: _____

Comments: _____


verification method: Written & legal descriptions, original construction record for this well, and Coffeyville West 1:24,000 topo map.

initials: ORL date: 10/31/2005

1 LOCATION OF WATER WELL: Fraction NW Section Number 53 Township Number 54 N Range Number R16
 County: Montgomery Co. $\frac{1}{4}$ $\frac{1}{4}$ $\frac{1}{4}$ EW

Distance and direction from nearest town or city street address of well if located within city?
Inglewood + 1st Coffeyville KS.

2 WATER WELL OWNER: The Williams Co
 RR #, St. Address, Box #: Williams Ctr. MO-48-06 Board of Agriculture, Division of Water Resources
 City, State, ZIP Code: Tulsa, OK. 74172 Application Number:

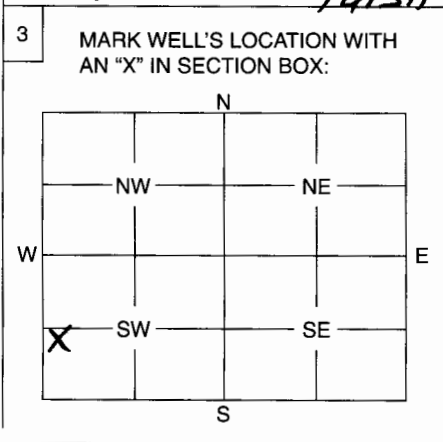

4 DEPTH OF WELL 13.80 ft.
 WELL'S STATIC WATER LEVEL ft.
 WELL WAS USED AS:
 1 Domestic 5 Public Water Supply 9 Dewatering
 2 Irrigation 6 Oil Field Water Supply 10 Monitoring Well
 3 Feedlot 7 Domestic (Lawn & Garden) 11 Injection Well
 4 Industrial 8 Air Conditioning 12 Other

Was a chemical / bacteriological sample submitted to Department? Yes No
 If yes, mo/day/yr sample was submitted

Water Well Disinfected: Yes No

5 TYPE OF BLANK CASING USED:
 1 Steel 3 RMP (SR) 5 Wrought 7 Fiberglass 9 Other (Specify below)
 2 PVC 4 ABS 6 Asbestos-Cement 8 Concrete Tile

Blank casing diameter in. Was casing pulled? Yes X No If yes, how much All
 Casing height above or below land surface in.

6 GROUT PLUG MATERIAL: 1 Neat cement 2 Cement grout 3 Bentonite 4 Other

Grout Plug Intervals: From ft. to ft., From ft. to ft., From ft. to ft.

What is the nearest source of possible contamination:
 1 Septic tank 6 Seepage pit 11 Fuel storage 16 Other (specify below)
 2 Sewer lines 7 Pit privy 12 Fertilizer storage
 3 Watertight sewer lines 8 Sewage lagoon 13 Insecticide storage
 4 Lateral lines 9 Feedyard 14 Abandoned water well
 5 Cess pool 10 Livestock pens 15 Oil well/Gas well

Direction from well? How many feet?

FROM	TO	PLUGGING MATERIALS
<u>13.8</u>	<u>0</u>	<u>Portland Cement</u>

7 CONTRACTOR'S OF LANDOWNER'S CERTIFICATION: This water well was plugged under my jurisdiction and was completed on (mo/day/year) 8-26-05 and this record is true to the best of my knowledge and belief. Kansas Water Well Contractor's License No. 05 This Water Well Record was completed on (mo/day/year) under the business name of Cherokee America Drilling by (signature) [Signature]

INSTRUCTIONS: Use typewriter or ball point pen. Please press firmly and print clearly. Please fill in blanks, underline or circle the correct answers. Send top three copies to Kansas Department of Health and Environment, Bureau of Water, Geology Section, 1000 SW Jackson St., Ste. 420, Topeka, Kansas 66612-1367. Telephone: 785/296-5522. Send one to Water Well Owner and retain one for your records.