

CORRECTION(S) TO WATER WELL RECORD (WWC-5)

(to rectify lacking or incorrect information)

Location listed as:

Section-Township-Range: 33-34N-16EFraction ($\frac{1}{4}$ $\frac{1}{4}$ $\frac{1}{4}$): NWCounty: Montgomery

Location changed to:

33-34S-16ESW SW NW

Other changes: Initial statements: _____

Changed to: _____

Comments: Plat map on form believed to represent NW 1/4 of sec.verification method: Written & legal descriptions, position on plat map, other monitoring wells in same vicinity for same owner, and Coffeyville West 1:24,000 topo. map. initials: DRP date: 11/1/2005


submitted by: Kansas Geological Survey, Data Resources Library, 1930 Constant Ave., Lawrence, KS 66047-3726

to: Kansas Dept of Health & Environment, Bureau of Water, 1000 SW Jackson, Suite 420, Topeka, KS 66612-1367.

1 LOCATION OF WATER WELL: Fraction NW Section Number 33 Township Number 34 N Range Number R16 E/W
 County: Montgomery Co.

Distance and direction from nearest town or city street address of well if located within city?
Inglewood + 1st Coffeyville KS.

2 WATER WELL OWNER: The Williams Co.
 RR #, St. Address, Box #: 1 Williams CNTR MD-48-06 Board of Agriculture, Division of Water Resources
 City, State, ZIP Code: Tulsa, OK - 74172 Application Number:

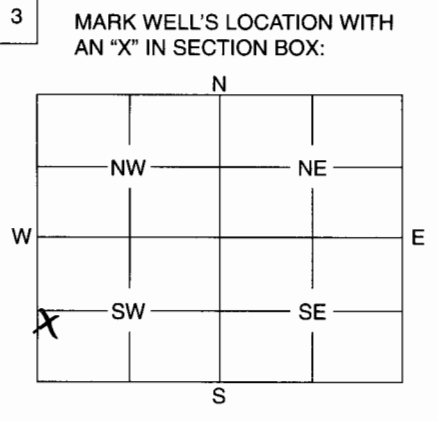

4 DEPTH OF WELL 11.00' ft.
 WELL'S STATIC WATER LEVEL ft.
 WELL WAS USED AS:
 1 Domestic 5 Public Water Supply 9 Dewatering
 2 Irrigation 6 Oil Field Water Supply 10 Monitoring Well
 3 Feedlot 7 Domestic (Lawn & Garden) 11 Injection Well
 4 Industrial 8 Air Conditioning 12 Other

Was a chemical / bacteriological sample submitted to Department? Yes No
 If yes, mo/day/yr sample was submitted

Water Well Disinfected: Yes No

5 TYPE OF BLANK CASING USED:
 1 Steel 3 RMP (SR) 5 Wrought 7 Fiberglass 9 Other (Specify below)
 2 PVC 4 ABS 6 Asbestos-Cement 8 Concrete Tile

Blank casing diameter in. Was casing pulled? Yes X No If yes, how much A.11

Casing height above or below land surface in.

6 GROUT PLUG MATERIAL: 1 Neat cement 2 Cement grout 3 Bentonite 4 Other

Grout Plug Intervals: From ft. to ft., From ft. to ft., From to ft.

What is the nearest source of possible contamination:
 1 Septic tank 6 Seepage pit 11 Fuel storage 16 Other (specify below)
 2 Sewer lines 7 Pit privy 12 Fertilizer storage

3 Watertight sewer lines 8 Sewage lagoon 13 Insecticide storage

4 Lateral lines 9 Feedyard 14 Abandoned water well

5 Cess pool 10 Livestock pens 15 Oil well/Gas well

Direction from well? How many feet?

FROM	TO	PLUGGING MATERIALS
<u>11'</u>	<u>Ø</u>	<u>Portland Cement</u>

7 CONTRACTOR'S OF LANDOWNER'S CERTIFICATION: This water well was plugged under my jurisdiction and was completed on (mo/day/year) 8/28/15 and this record is true to the best of my knowledge and belief. Kansas Water Well Contractor's License No. 605 This Water Well Record was completed on (mo/day/year) under the business name of Cherokee America Drilling by (signature) J. Walsh

INSTRUCTIONS: Use typewriter or ball point pen. Please press firmly and print clearly. Please fill in blanks, underline or circle the correct answers. Send top three copies to Kansas Department of Health and Environment, Bureau of Water, Geology Section, 1000 SW Jackson St., Ste. 420, Topeka, Kansas 66612-1367. Telephone: 785/296-5522. Send one to Water Well Owner and retain one for your records.