

County: Montgomery Fraction SW SW NW Sec. 33 T 34 S R 16 (E/W)

CORRECTION(S) TO WATER WELL COMPLETION RECORD (WWC-5)

(to rectify lacking or incorrect information)

Owner: The Williams Companies

Location was listed as:

Section-Township-Range: 32-N34-16E

Fraction (1/4 1/4 1/4): NE

Location changed to:

33-34S-16E

SW SW NW

Other changes: Initial statements: _____

Changed to: _____

Comments: KDHE online report, Project Code C3-063-03011, Williams Pipeline Madden Site, Coffeyville Spill gives latitude 37.044660, longitude -95.673190, which equates to SE SW SW NW 33-34S-16E.


Verification method: Location given on original construction record, above-cited lat./long., and mapping tool on KGS website.

Submitted by: Kansas Geological Survey, Data Resources Library, 1930 Constant Ave., Lawrence, KS 66047-3726 initials: DRd date: 9/21/2012
to: Kansas Dept of Health & Environment, Bureau of Water, 1000 SW Jackson, Suite 420, Topeka, KS 66612-1367.

| | | | | |
|---------------------------|---|----------------|--------------------|--|
| 1 LOCATION OF WATER WELL: | Fraction | Section Number | Township Number | Range Number |
| County: <u>Montgomery</u> | $\frac{1}{4}$ $\frac{1}{4}$ <u>NE</u> $\frac{1}{4}$ | <u>32</u> | <u>N</u> <u>34</u> | <u>16</u> (EW) |

Distance and direction from nearest town or city street address of well if located within city?
Corrooyville KS Inglewood st to 1st street

2 WATER WELL OWNER: The Williams Companies
 RR #, St. Address, Box #: one Williams Center MD 486 Board of Agriculture, Division of Water Resources
 City, State, ZIP Code: Tulsa OK 74172 Application Number:

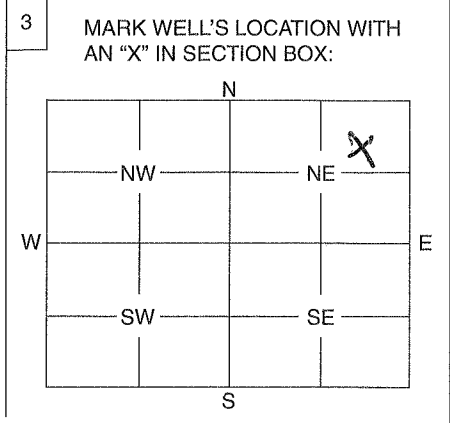

4 DEPTH OF WELL 16.5 ft.
 WELL'S STATIC WATER LEVEL N.S. ft.
 WELL WAS USED AS:

| | | |
|--------------|----------------------------|---------------------------|
| 1 Domestic | 5 Public Water Supply | 9 Dewatering |
| 2 Irrigation | 6 Oil Field Water Supply | 10 <u>Monitoring Well</u> |
| 3 Feedlot | 7 Domestic (Lawn & Garden) | 11 Injection Well |
| 4 Industrial | 8 Air Conditioning | 12 Other |

Was a chemical / bacteriological sample submitted to Department? Yes No X
 If yes, mo/day/yr sample was submitted

Water Well Disinfected: Yes No X

5 TYPE OF BLANK CASING USED:

| | | | | |
|--------------|------------|-------------------|-----------------|-------------------------|
| 1 Steel | 3 RMP (SR) | 5 Wrought | 7 Fiberglass | 9 Other (Specify below) |
| <u>2 PVC</u> | 4 ABS | 6 Asbestos-Cement | 8 Concrete Tile | |

Blank casing diameter 4 in. Was casing pulled? Yes X No If yes, how much All
 Casing height above or below land surface 6 in.

6 GROUT PLUG MATERIAL: 1 Neat cement 2 Cement grout 3 Bentonite 4 Other
 Grout Plug Intervals: From 16.5 ft. to 0 ft., From ft. to ft., From to 0 ft.

What is the nearest source of possible contamination:

| | | | |
|--------------------------|-------------------|-------------------------|--------------------------|
| 1 Septic tank | 6 Seepage pit | 11 Fuel storage | 16 Other (specify below) |
| 2 Sewer lines | 7 Pit privy | 12 Fertilizer storage | |
| 3 Watertight sewer lines | 8 Sewage lagoon | 13 Insecticide storage | |
| 4 Lateral lines | 9 Feedyard | 14 Abandoned water well | |
| 5 Cess pool | 10 Livestock pens | 15 Oil well/Gas well | |

Direction from well? How many feet?

| FROM | TO | PLUGGING MATERIALS |
|-------------|----------|---------------------------------------|
| <u>16.5</u> | <u>0</u> | <u>Portland Cement with Bentonite</u> |
| | | |
| | | |
| | | |
| | | |

7 CONTRACTOR'S OF LANDOWNER'S CERTIFICATION: This water well was plugged under my jurisdiction and was completed on (mo/day/year) 8/27/05 and this record is true to the best of my knowledge and belief. Kansas Water Well Contractor's License No. 605 This Water Well Record was completed on (mo/day/year) under the business name of Cherokee American Drilling by (signature) S. Wells

INSTRUCTIONS: Use typewriter or ball point pen. Please press firmly and print clearly. Please fill in blanks, underline or circle the correct answers. Send top three copies to Kansas Department of Health and Environment, Bureau of Water, Geology Section, 1000 SW Jackson St., Ste. 420, Topeka, Kansas 66612-1367. Telephone: 785/296-5522. Send one to Water Well Owner and retain one for your records.