


1 LOCATION OF WATER WELL: County: Montgomery	Fraction SE ¼ NE ¼ SW ¼	Section Number 36	Township Number T 34 S	Range Number R 16	E/W
--	-----------------------------------	-----------------------------	----------------------------------	-----------------------------	------------

Distance and direction from nearest town or city street address of well if located within city?

108 E. 4th, Coffeyville

2 WATER WELL OWNER: Clough Oil Company, Inc. RR#, St. Address, Box # : 108 East 4th Street City, State, ZIP Code : Coffeyville, KS 67337	Board of Agriculture, Division of Water Resources Application Number:
--	--

3 LOCATE WELL'S LOCATION WITH AN "X" IN SECTION BOX:

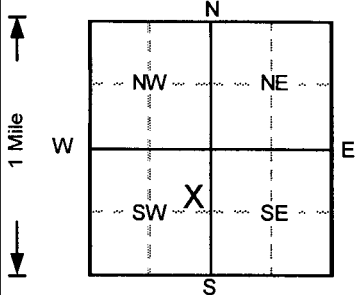

4 DEPTH OF COMPLETED WELL: 20 ft. ELEVATION: _____	Depth(s) Groundwater Encountered 1. _____ ft. 2. _____ ft. 3. _____ ft.
WELL'S STATIC WATER LEVEL: 16.65 ft. below land surface measured on mo/day/yr 2/7/2007	
Pump test data: Well water was NA ft. after _____ hours pumping _____ gpm	
Est. Yield NA gpm; Well water was _____ ft. after _____ hours pumping _____ gpm	
Bore Hole Diameter 8 in. to 20 ft., and _____ in. to _____ ft.	
WELL WATER TO BE USED AS: 5 Public water supply 8 Air conditioning 11 Injection well	
1 Domestic 3 Feedlot 6 Oil field water supply 9 Dewatering 12 Other (Specify below)	
2 Irrigation 4 Industrial 7 Lawn and garden only 10 Monitoring ^{well}	
Was a chemical/bacteriological sample submitted to Department? Yes.....No <input checked="" type="checkbox"/> ; If yes, mo/day/yr sample was submitted	
Water Well Disinfected? Yes _____ No <input checked="" type="checkbox"/>	

5 TYPE OF BLANK CASING USED:	5 Wrought iron	8 Concrete tile	CASING JOINTS: Glued _____ Clamped _____	
1 Steel	3 RMP (SR)	6 Asbestos-Cement	Welded _____	
2 PVC	4 ABS	7 Fiberglass	Threaded. <input checked="" type="checkbox"/>	
Blank casing diameter 2 in. to 10 ft., Dia _____ in. to _____ ft., Dia _____ in. to _____ ft.				
Casing height above land surface 0 in., weight _____ lbs./ft. Wall thickness or gauge No. Sch. 40				
TYPE OF SCREEN OR PERFORATION MATERIAL				
1 Steel	3 Stainless steel	5 Fiberglass	7 PVC	10 Asbestos-cement
2 Brass	4 Galvanized steel	6 Concrete tile	8 RMP (SR)	11 Other (specify) _____
SCREEN OR PERFORATION OPENINGS ARE:				
1 Continuous slot	3 Mill slot	5 Gauzed wrapped	8 Saw cut	11 None (open hole)
2 Louvered shutter	4 Key punched	6 Wire wrapped	9 Drilled holes	
SCREEN-PERFORATED INTERVALS: From 10 ft. to 20 ft., From _____ ft. to _____ ft.				
GRAVEL PACK INTERVALS: From 8 ft. to 20 ft., From _____ ft. to _____ ft.				

6 GROUT MATERIAL:	1 Neat cement	2 Cement grout	3 Bentonite	4 Other Concrete	Grout Intervals: From 0 ft. to 1 ft., From 1 ft. to 8 ft., From _____ ft. to _____ ft.
What is the nearest source of possible contamination:					
1 Septic tank	4 Lateral lines	7 Pit privy	10 Livestock pens	14 Abandoned water well	
2 Sewer lines	5 Cess pool	8 Sewage lagoon	11 Fuel storage	15 Oil well/Gas well	
3 Watertight sewer lines	6 Seepage pit	9 Feedyard	12 Fertilizer storage	16 Other (specify below)	
Direction from well? _____ How many feet? _____					

FROM	TO	LITHOLOGIC LOG	FROM	TO	PLUGGING INTERVALS
0	1	Topsoil (fill),			
1	1.5	Gravel (fill),			
1.5	2	Clay (fill), Black			
2	20	Shale, Tan/Gray			
CORRECTED					
MW6, Flushmount					
Project Name: GeoStat - Cloughs					
GeoCore # 1367, #					

7 CONTRACTOR'S OR LANDOWNER'S CERTIFICATION: This water well was **(1)** constructed, (2) reconstructed, or (3) plugged under my jurisdiction and was completed on (mo/day/year) **2/6/2007** and this record is true to the best of my knowledge and belief.
 Kansas Water Well Contractor's License No. **527** This Water Well Record was completed on (mo/day/yr) **3/5/07**
 under the business name of **GeoCore, Inc.** by (signature) *Paul 124*