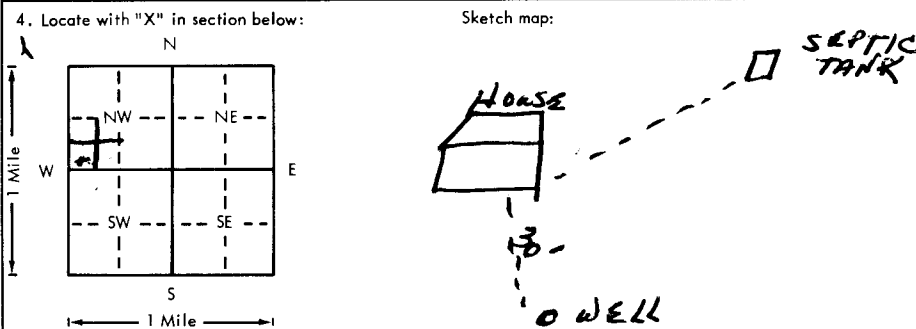


USE TYPEWRITER OR BALL POINT PEN-PRESS FIRMLY, PRINT CLEARLY.

WATER WELL RECORD
KSA 82a-1201-1215

Kansas Department of Health and Environment-Division of Environment
(Water well Contractors)
Topeka, Kansas 66620

1. Location of well: County MONTGOMERY Fraction SW 1/4 SW 1/4 NW 1/4 Section number 16 Township number T 34 S R 16 E/W Range number	
2. Distance and direction from nearest town or city: 1 MILE NORTH OF DEARING, KANS. 2 MILE EAST. 1/8 NORTH 3. Owner of well: JIMMIE R. WIEBE R.R. or street: 602 W. 5th Street address of well location if in city: EAST SIDE City, state, zip code: COFFEYVILLE KANS. 67337	
4. Locate with "X" in section below: Sketch map: 	
6. Bore hole dia. 9 in. Completion date 11-6-78 Well depth 37 ft.	
7. <input checked="" type="checkbox"/> Cable tool <input type="checkbox"/> Rotary <input type="checkbox"/> Driven <input type="checkbox"/> Dug <input type="checkbox"/> Hollow rod <input type="checkbox"/> Jetted <input type="checkbox"/> Bored <input type="checkbox"/> Reverse rotary	
8. Use: <input checked="" type="checkbox"/> Domestic <input type="checkbox"/> Public supply <input type="checkbox"/> Industry <input type="checkbox"/> Irrigation <input type="checkbox"/> Air conditioning <input type="checkbox"/> Stock <input type="checkbox"/> Lawn <input type="checkbox"/> Oil field water <input type="checkbox"/> Other	
9. Casing: Material Plastic Height: Above or below Threading: <input type="checkbox"/> Threaded <input type="checkbox"/> Welded <input type="checkbox"/> Surface 12 in. RMP: <input type="checkbox"/> PVC 40 Weight: _____ lbs./ft. Dia. 6 in. to 37 ft. depth Wall Thickness: _____ inches or Dia. _____ in. to _____ ft. depth Gage No. 0.320	
5. Type and color of material	
From To	
QUICK SAND WATER 19 to 25 0 25	
GRAY SHALE 25 37	
Bottom 20' slotted.	
10. Screen: Manufacturer's name _____ Type _____ Dia. _____ Dia./gauze 1/8" Length 20' Set between 0 ft. and 37 ft. _____ ft. and _____ ft. Gravel pack? <input checked="" type="checkbox"/> Size range of material 1/4 - 1/2	
11. Static water level: _____ mo./day/yr. 20 ft. below land surface Date 11-6-78	
12. Pumping level below land surfaces: _____ ft. after _____ hrs. pumping _____ g.p.m. _____ ft. after _____ hrs. pumping _____ g.p.m. Estimated maximum yield 2 g.p.m.	
13. Water sample submitted: _____ mo./day/yr. Yes <input type="checkbox"/> No <input checked="" type="checkbox"/> Date _____	
14. Well head completion: _____ Pitless adapter _____ Inches above grade	
15. Well grouted? YES With: <input checked="" type="checkbox"/> Neat cement <input type="checkbox"/> Bentonite <input type="checkbox"/> Concrete Depth: From 0 ft. to 10 ft.	
16. Nearest source of possible contamination: NONE ft. _____ Direction _____ Type _____ Well disinfected upon completion? <input checked="" type="checkbox"/> Yes <input type="checkbox"/> No	
17. Pump: <input checked="" type="checkbox"/> Not installed Manufacturer's name _____ Model number _____ HP _____ Volts _____ Length of drop pipe _____ ft. capacity _____ g.p.m. Type: _____ Submersible _____ Turbine _____ Jet _____ Reciprocating _____ Centrifugal _____ Other _____	
(Use a second sheet if needed)	
18. Elevation: Topography: _____ Hill _____ Slope _____ Upland _____ Valley	19. Remarks: CUSTOMER TO INSTALL CONCRETE SLAB. HE KNOWS THIS IS A STATE REGULATION.
20. Water well contractor's certification: This well was drilled under my jurisdiction and this report is true to the best of my knowledge and belief. MOORE DRILLING CO. 345A Business name Bit 2 License No. Address LEOLA, KANS. Signed Debra M. Moore Date 11-6-78 Authorized representative	

34 T 34 S R 16 E/W Sec 16

Forward the white, blue and pink copies to the Department of Health and Environment

Form WWC-5