


1 LOCATION OF WATER WELL: Fraction SE 1/4 NE 1/4 NE 1/4 Section Number 18 Township Number T 34 S Range Number R 16 E/W
 County: Montgomery

Distance and direction from nearest town or city street address of well if located within city? 2 mile North - 1 mile East 1/2 mile North of Dearing Kansas

2 WATER WELL OWNER: Donald Collier PRA
 RR#, St. Address, Box #: Dearing, KS
 City, State, ZIP Code: Dearing, KS
 Board of Agriculture, Division of Water Resources
 Application Number:

3 LOCATE WELL'S LOCATION WITH AN "X" IN SECTION BOX:

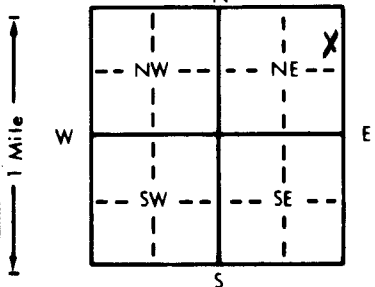

4 DEPTH OF COMPLETED WELL: 10.4 ft. ELEVATION: 6
 Depth(s) Groundwater Encountered 1. 5.1 ft. 2. . ft. 3. . ft.
 WELL'S STATIC WATER LEVEL 1.7 ft. below land surface measured on mo/day/yr 6-22-81
 Pump test data: Well water was . ft. after . hours pumping . gpm
 Est. Yield 1.12 gpm. Well water was . ft. after . hours pumping . gpm
 Bore Hole Diameter: 9 3/4 in. to 2.4 ft., and 5 1/2 in. to 10.4 ft.
 WELL WATER TO BE USED AS:
 Domestic 3 Feedlot 6 Oil field water supply 9 Dewatering 12 Other (Specify below)
 2 Irrigation 4 Industrial 7 Lawn and garden only 10 Observation well
 Was a chemical/bacteriological sample submitted to Department? Yes . No ; if yes, mo/day/yr sample was submitted
 Water Well Disinfected? Yes No

5 TYPE OF BLANK CASING USED:
 1 Steel 3 RMP (SR) 5 Wrought iron 8 Concrete tile CASING JOINTS: Glued Clamped .
 2 PVC 4 ABS 7 Fiberglass . Welded .
 Blank casing diameter 6 in. to 2.4 ft., Dia . in. to . ft., Dia . in. to . ft.
 Casing height above land surface 1.6 in., weight 3.91 lbs./ft. Wall thickness or gauge No. 0.316

TYPE OF SCREEN OR PERFORATION MATERIAL:
 1 Steel 3 Stainless steel 5 Fiberglass 8 RMP (SR) 10 Asbestos-cement
 2 Brass 4 Galvanized steel 6 Concrete tile 9 ABS 11 Other (specify) .
 12 None used (open hole)

SCREEN OR PERFORATION OPENINGS ARE:
 1 Continuous slot 3 Mill slot 5 Gauzed wrapped 8 Saw cut 11 None (open hole)
 2 Louvered shutter 4 Key punched 6 Wire wrapped 9 Drilled holes
 7 Torch cut 10 Other (specify) .

SCREEN-PERFORATED INTERVALS: From . ft. to . ft., From . ft. to . ft., From . ft. to . ft.
 GRAVEL PACK INTERVALS: From None Used ft. to . ft., From . ft. to . ft., From . ft. to . ft.

6 GROUT MATERIAL: 1 Neat cement 2 Cement grout 3 Bentonite 4 Other .
 Grout Intervals: 1 ft. to 14 ft., From . ft. to . ft., From . ft. to . ft.

What is the nearest source of possible contamination:
 1 Septic tank 4 Lateral lines 7 Pit privy 10 Livestock pens 14 Abandoned water well
 2 Sewer lines 5 Cess pool 8 Sewage lagoon 11 Fuel storage 15 Oil well/Gas well
 3 Watertight sewer lines 6 Seepage pit 9 Feedyard 12 Fertilizer storage 16 Other (specify below) Pond
 Direction from well? North How many feet? 1500

| FROM | TO | LITHOLOGIC LOG | FROM | TO | LITHOLOGIC LOG |
|------|----|----------------|------|----|----------------|
| 1 | 2 | soil | | | |
| 3 | 4 | sandstone | | | |
| 4 | 5 | lime rock | | | |
| 5 | 6 | shale | | | |
| 6 | 7 | lime | | | |
| 7 | 8 | shale | | | |
| 8 | 9 | lime rock | | | |

7 CONTRACTOR'S OR LANDOWNER'S CERTIFICATION: This water well was (1) constructed, (2) reconstructed, or (3) plugged under my jurisdiction and was completed on (mo/day/year) 6-22-81 and this record is true to the best of my knowledge and belief. Kansas Water Well Contractor's License No. 428 This Water Well Record was completed on (mo/day/yr) 6-23-81 under the business name of Prairie Drilling by (signature) Jasper Marshall

INSTRUCTIONS: Use typewriter or ball point pen. PLEASE PRESS FIRMLY and PRINT clearly. Please fill in blanks, underline or circle the correct answers. Send top three copies to Kansas Department of Health and Environment, Division of Environment, Environmental Geology Section, Topeka, KS 66620. Send one to WATER WELL OWNER and retain one for your records.

OFFICE USE ONLY
T
34
R
16
CEN
SEC
18
SE 1/4
NE 1/4
NE 1/4