


RMW-III

1 LOCATION OF WATER WELL: Fraction **NW 1/4 SE 1/4 SE 1/4** Section Number **25** Township Number **T 34 S** Range Number **R 16E E/W**
 County: **Montgomery**
 Distance and direction from nearest town or city street address of well if located within city?

COFFEYVILLE

2 WATER WELL OWNER: **FARMLAND INDUSTRIES INC**
 RR#, St. Address, Box #: **P.O. Box 570** Board of Agriculture, Division of Water Resources
 City, State, ZIP Code: **COFFEYVILLE, KS 67337** Application Number:

3 LOCATE WELL'S LOCATION WITH AN "X" IN SECTION BOX:

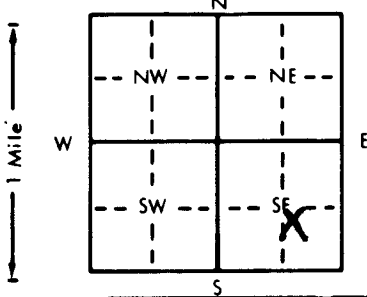

4 DEPTH OF COMPLETED WELL: **30.0** ft. ELEVATION: **16.0** ft.
 Depth(s) Groundwater Encountered: **1. 16.0** ft. 2. ft. 3. ft.
 WELL'S STATIC WATER LEVEL ft. below land surface measured on mo/day/yr
 Pump test data: Well water was ft. after hours pumping gpm
 Est. Yield gpm: Well water was ft. after hours pumping gpm
 Bore Hole Diameter: **8 3/4** in. to **30.0** ft., and in. to ft.
 WELL WATER TO BE USED AS: 5 Public water supply 8 Air conditioning 11 Injection well
 1 Domestic 3 Feedlot 6 Oil field water supply 9 Dewatering 12 Other (Specify below)
 2 Irrigation 4 Industrial 7 Lawn and garden only **10** Monitoring well
 Was a chemical/bacteriological sample submitted to Department? Yes **No**; If yes, mo/day/yr sample was submitted
 Water Well Disinfected? Yes **No**

5 TYPE OF BLANK CASING USED: 1 Steel 3 RMP (SR) 5 Wrought iron 8 Concrete tile CASING JOINTS: Glued Clamped
2 PVC 4 ABS 6 Asbestos-Cement 9 Other (specify below) Welded
 7 Fiberglass Threaded
 Blank casing diameter **2** in. to ft., Dia in. to ft., Dia in. to ft.
 Casing height above land surface **24** in., weight lbs./ft. Wall thickness or gauge No. **Schedule 40**
 TYPE OF SCREEN OR PERFORATION MATERIAL: **17** PVC 10 Asbestos-cement
 1 Steel 3 Stainless steel 5 Fiberglass 8 RMP (SR) 11 Other (specify)
 2 Brass 4 Galvanized steel 6 Concrete tile 9 ABS 12 None used (open hole)
 SCREEN OR PERFORATION OPENINGS ARE: 5 Gauzed wrapped 8 Saw cut 11 None (open hole)
 1 Continuous slot **3** Mill slot 6 Wire wrapped 9 Drilled holes
 2 Louvered shutter 4 Key punched 7 Torch cut 10 Other (specify)
 SCREEN-PERFORATED INTERVALS: From **14.0** ft. to **24.0** ft., From ft. to ft.
 From ft. to ft., From ft. to ft.
 GRAVEL PACK INTERVALS: From **12.0** ft. to **24.0** ft., From ft. to ft.
 From ft. to ft., From ft. to ft.

6 GROUT MATERIAL: 1 Neat cement 2.5 Cement grout **3** Bentonite 4 Other
 Grout Intervals: From **0.0** ft. to **2.5** ft., From **2.5** ft. to **12.0** ft., From ft. to ft.
 What is the nearest source of possible contamination:
 1 Septic tank 4 Lateral lines 7 Pit privy **10** Livestock pens 14 Abandoned water well
 2 Sewer lines 5 Cess pool 8 Sewage lagoon **11** Fuel storage 15 Oil well/Gas well
 3 Watertight sewer lines 6 Seepage pit 9 Feedyard 12 Fertilizer storage 16 Other (specify below)
 13 Insecticide storage
 Direction from well? **IN REFINERY** How many feet?

FROM	TO	LITHOLOGIC LOG	FROM	TO	PLUGGING INTERVALS
0.0	25.0	BROWN SILT - MOIST/SOFT			
25.0	29.0	BROWN SILT/SAND/GRAVEL			
29.0	29.0	GRAY SHALE - DRY/HARD			

7 CONTRACTOR'S OR LANDOWNER'S CERTIFICATION: This water well was **1** constructed, (2) reconstructed, or (3) plugged under my jurisdiction and was completed on (mo/day/year) **6-30-94** and this record is true to the best of my knowledge and belief. Kansas Water Well Contractor's License No. **551** This Water Well Record was completed on (mo/day/yr) **6-30-94** under the business name of **Associated Environmental Industries** by (signature)

OFFICE USE ONLY
T
R
EW
SEC.