


1 LOCATION OF WATER WELL: Fraction **NW 1/4 SE 1/4 SE 1/4** Section Number **25** Township Number **T 34 S** Range Number **R 16 E E/W**  
 County: **Montgomery**  
 Distance and direction from nearest town or city street address of well if located within city?  
**COFFEYVILLE**

2 WATER WELL OWNER: **FARMLAND INDUSTRIES INC.**  
 RR#, St. Address, Box #: **P.O. BOX 570** Board of Agriculture, Division of Water Resources  
 City, State, ZIP Code: **COFFEYVILLE, KS 67337** Application Number:

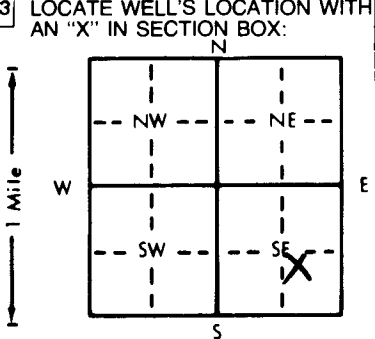

4 DEPTH OF COMPLETED WELL: **20.5** ft. ELEVATION:  
 Depth(s) Groundwater Encountered 1. **13.0** ft. 2. ft. 3. ft.  
 WELL'S STATIC WATER LEVEL ft. below land surface measured on mo/day/yr  
 Pump test data: Well water was ft. after hours pumping gpm  
 Est. Yield gpm: Well water was ft. after hours pumping gpm  
 Bore Hole Diameter: **8 3/4** in. to **20.5** ft., and in. to ft.  
 WELL WATER TO BE USED AS:  
 5 Public water supply 8 Air conditioning 11 Injection well  
 1 Domestic 3 Feedlot 6 Oil field water supply 9 Dewatering 12 Other (Specify below)  
 2 Irrigation 4 Industrial 7 Lawn and garden only **10** Monitoring well  
 Was a chemical/bacteriological sample submitted to Department? Yes  No ; If yes, mo/day/yr sample was submitted  
 Water Well Disinfected? Yes  No

5 TYPE OF BLANK CASING USED:  
 1 Steel 3 RMP (SR) 5 Wrought iron 8 Concrete tile CASING JOINTS: Glued Clamped  
 2 PVC 4 ABS 6 Asbestos-Cement 9 Other (specify below) Welded  
 7 Fiberglass Threaded  
 Blank casing diameter **2** in. to **15.0** ft. Dia. in. to ft. Dia. in. to ft.  
 Casing height above land surface **24** in. weight lbs./ft. Wall thickness or gauge No **Schedule 40**  
 TYPE OF SCREEN OR PERFORATION MATERIAL:  
 1 Steel 3 Stainless steel 5 Fiberglass 8 RMP (SR) 10 Asbestos-cement  
 2 Brass 4 Galvanized steel 6 Concrete tile 9 ABS 11 Other (specify)  
 12 None used (open hole)  
 SCREEN OR PERFORATION OPENINGS ARE:  
 1 Continuous slot 3 Mill slot 5 Gauzed wrapped 8 Saw cut 11 None (open hole)  
 2 Louvered shutter 4 Key punched 6 Wire wrapped 9 Drilled holes  
 7 Torch cut 10 Other (specify)  
 SCREEN-PERFORATED INTERVALS: From **15.0** ft. to **20.0** ft. From ft. to ft.  
 From ft. to ft. From ft. to ft.  
 GRAVEL PACK INTERVALS: From **13.0** ft. to **20.0** ft. From ft. to ft.  
 From ft. to ft. From ft. to ft.

6 GROUT MATERIAL: 1 Neat cement 2.5 Cement grout 3 Bentonite 4 Other  
 Grout Intervals: From **0.0** ft. to **2.5** ft. From **2.5** ft. to **13.0** ft. From ft. to ft.  
 What is the nearest source of possible contamination:  
 1 Septic tank 4 Lateral lines 7 Pit privy 10 Livestock pens 14 Abandoned water well  
 2 Sewer lines 5 Cess pool 8 Sewage lagoon 11 Fuel storage 15 Oil well/Gas well  
 3 Watertight sewer lines 6 Seepage pit 9 Feedyard 12 Fertilizer storage 16 Other (specify below)  
 13 Insecticide storage  
 Direction from well? **IN REFINERY** How many feet?

FROM	TO	LITHOLOGIC LOG	FROM	TO	PLUGGING INTERVALS
0.0	16.0	BROWN SILTY CLAY -MOIST/STIFF			
16.0	20.0	BROWN SILTY SAND & GRAVEL -WET			
20.0	20.0	BROWN LIMESTONE-HARD			

7 CONTRACTOR'S OR LANDOWNER'S CERTIFICATION: This water well was **(1)** constructed, (2) reconstructed, or (3) plugged under my jurisdiction and was completed on (mo/day/year) **7-1-94** and this record is true to the best of my knowledge and belief. Kansas Water Well Contractor's License No. **551** This Water Well Record was completed on (mo/day/yr) **7-1-94** under the business name of **Associated Environmental Industries** by (signature)

OFFICE USE ONLY  
T  
R  
EW  
SEC.