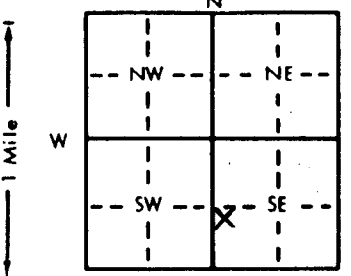


1] LOCATION OF WATER WELL: County: Montgomery Fraction NW  $\frac{1}{4}$  SW  $\frac{1}{4}$  SE  $\frac{1}{4}$  Section Number 25 Township Number T 34 S Range Number R 16 **EW**

Distance and direction from nearest town or city street address of well if located within city?  
North Linden Street, Coffeyville, Ks.

2] WATER WELL OWNER: Farmland Industries - Coffeyville Refinery  
 RR#, St. Address, Box #: North Linden Street Board of Agriculture, Division of Water Resources  
 City, State, ZIP Code: Coffeyville, Ks. 67337 Application Number:

3] LOCATE WELL'S LOCATION WITH AN "X" IN SECTION BOX:  
  
 4] DEPTH OF COMPLETED WELL: 36.10 ft. ELEVATION: .....  
 Depth(s) Groundwater Encountered 1. 22.53 ft. 2. .... ft. 3. .... ft.  
 WELL'S STATIC WATER LEVEL ..... ft. below land surface measured on mo/day/yr .....  
 Pump test data: Well water was ..... ft. after ..... hours pumping ..... gpm  
 Est. Yield ..... gpm: Well water was ..... ft. after ..... hours pumping ..... gpm  
 Bore Hole Diameter: 8 in. to 36.2 ft., and ..... in. to ..... ft.  
 WELL WATER TO BE USED AS:  
 5 Public water supply 8 Air conditioning 11 Injection well  
 1 Domestic 3 Feedlot 6 Oil field water supply 9 Dewatering 12 Other (Specify below)  
 2 Irrigation 4 Industrial 7 Lawn and garden only **10** Monitoring well .....  
 Was a chemical/bacteriological sample submitted to Department? Yes.....No. ; If yes, mo/day/yr sample was submitted  
 Water Well Disinfected? Yes No

5] TYPE OF BLANK CASING USED:  
 1 Steel 2 Stainless 3 RMP (SR) 5 Wrought iron 8 Concrete tile CASING JOINTS: Glued ..... Clamped .....  
 2 PVC 4 ABS 7 Fiberglass 9 Other (specify below) Welded .....  
 3 RMP (SR) 6 Asbestos-Cement Threaded.   
 Blank casing diameter 2 SS in. to 34 ft., Dia. 2 PVC in. to 14 ft., Dia. .... in. to ..... ft.  
 Casing height above land surface: 24 in., weight ..... lbs./ft. Wall thickness or gauge No. Sch. 5 SS .....  
 TYPE OF SCREEN OR PERFORATION MATERIAL:  
 1 Steel 2 Brass 3 Stainless steel 4 Galvanized steel 5 Fiberglass 6 Concrete tile 7 PVC 8 RMP (SR) 9 ABS 10 Asbestos-cement 11 Other (specify) ..... 12 None used (open hole)  
 SCREEN OR PERFORATION OPENINGS ARE:  
 1 Continuous slot 2 Louvered shutter 3 Mill slot 4 Key punched 5 Gauzed wrapped 6 Wire wrapped .010 7 Torch cut 8 Saw cut 9 Drilled holes 11 None (open hole)  
 SCREEN-PERFORATED INTERVALS: From 36 ft. to 34 ft., From ..... ft. to ..... ft.  
 GRAVEL PACK INTERVALS: From 36 ft. to 32 ft., From ..... ft. to ..... ft.

6] GROUT MATERIAL: 1 Neat cement 2 Cement grout 3 Bentonite 4 Other .....  
 Grout Intervals: From 32 ft. to 4 (bent) ft., From 4 ft. to 0 (cem) ft., From ..... ft. to ..... ft.  
 What is the nearest source of possible contamination:  
 1 Septic tank 2 Sewer lines 3 Watertight sewer lines 4 Lateral lines 5 Cess pool 6 Seepage pit 7 Pit privy 8 Sewage lagoon 9 Feedyard 10 Livestock pens 11 Fuel storage 12 Fertilizer storage 13 Insecticide storage 14 Abandoned water well 15 Oil well/Gas well 16 Other (specify below) Refinery

Direction from well? at refinery How many feet? ?

FROM	TO	LITHOLOGIC LOG	FROM	TO	PLUGGING INTERVALS
0	2	SILT CLAYEY, BROWN			
2	12	CLAY SILTY, BROWN, GRAY			MW19
12	14	SILT CLAYEY, GRAY/BROWN			
14	15	CLAY, LIGHT BROWN			
15	18	SILT CLAYEY, GRAY, LIGHT BROWN			
18	24	SILT CLAYEY, GRAY/ORANGE			
24	32	SILT CLAYEY, GRAY/ORANGE			
32	34	SILT-TAN, GRAY			
34	36.2	SAND GRAVELLY, CLAYEY, SILTY, OLIVE-TAN			
36.2		BEDROCK			

7] CONTRACTOR'S OR LANDOWNER'S CERTIFICATION: This water well was **1** constructed, (2) reconstructed, or (3) plugged under my jurisdiction and was completed on (mo/day/year) 09-07-93 and this record is true to the best of my knowledge and belief. Kansas Water Well Contractor's License No. 527 This Water Well Record was completed on (mo/day/yr) 10-08-93 under the business name of GeoCore Services, Inc. by (signature) Dale Roll