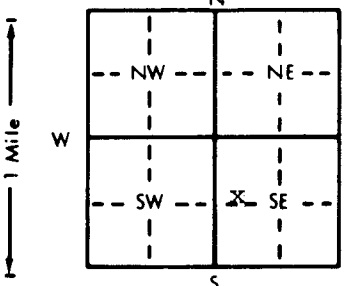


1 LOCATION OF WATER WELL: County: <b>Montgomery</b>	Fraction <b>SW 1/4 NW 1/4 SE 1/4</b>	Section Number <b>25</b>	Township Number <b>T 34 S</b>	Range Number <b>R 16 E 4</b>
--	---	-----------------------------	----------------------------------	---------------------------------

Distance and direction from nearest town or city street address of well if located within city?  
**1/8 mi north of North Linden**

2 WATER WELL OWNER: **Farmland Industries**  
 RR#, St. Address, Box #: **North Linden**  
 City, State, ZIP Code: **Coffeyville, KS 67337**  
 Board of Agriculture, Division of Water Resources  
 Application Number:

3 LOCATE WELL'S LOCATION WITH AN "X" IN SECTION BOX:  


4 DEPTH OF COMPLETED WELL: **35.6** ft. ELEVATION:  
 Depth(s) Groundwater Encountered 1. **33** ft. 2. ft. 3. ft.  
 WELL'S STATIC WATER LEVEL ft. below land surface measured on mo/day/yr  
 Pump test data: Well water was ft. after hours pumping gpm  
 Est. Yield gpm: Well water was ft. after hours pumping gpm  
 Bore Hole Diameter: **7.25** in. to **35.6** ft., and in. to ft.  
 WELL WATER TO BE USED AS:  
 5 Public water supply 8 Air conditioning 11 Injection well  
 1 Domestic 3 Feedlot 6 Oil field water supply 9 Dewatering 12 Other (Specify below)  
 2 Irrigation 4 Industrial 7 Lawn and garden only **10 Monitoring well**  
 Was a chemical/bacteriological sample submitted to Department? Yes.....No. **X**.....; If yes, mo/day/yr sample was submitted  
 Water Well Disinfected? Yes **No**

5 TYPE OF BLANK CASING USED:  
 1 Steel 3 RMP (SR) 5 Wrought iron 8 Concrete tile CASING JOINTS: Glued Clamped  
**2 PVC** 4 ABS 6 Asbestos-Cement 9 Other (specify below) Welded  
 7 Fiberglass **Stainless Steel** Threaded **X**  
 Blank casing diameter 2 in. to 25.6 ft., Dia in. to ft., Dia in. to ft.  
 Casing height above land surface 24 in., weight lbs./ft. Wall thickness or gauge No. **0.18 in.**  
 TYPE OF SCREEN OR PERFORATION MATERIAL:  
 1 Steel 3 **Stainless steel** 5 Fiberglass 7 PVC 10 Asbestos-cement  
 2 Brass 4 Galvanized steel 6 Concrete tile 8 RMP (SR) 11 Other (specify)  
 12 None used (open hole)  
 SCREEN OR PERFORATION OPENINGS ARE:  
 1 Continuous slot 3 Mill slot 5 Gauzed wrapped 8 Saw cut 11 None (open hole)  
 2 Louvered shutter 4 Key punched 6 **Wire wrapped** 9 Drilled holes  
 7 Torch cut 10 Other (specify)  
 SCREEN-PERFORATED INTERVALS: From 25.6 ft. to 35.6 ft., From ft. to ft.  
 From ft. to ft., From ft. to ft.  
 GRAVEL PACK INTERVALS: From 23 ft. to 35.6 ft., From ft. to ft.  
 From ft. to ft., From ft. to ft.

6 GROUT MATERIAL: **1 Neat cement** 2 Cement grout **3 Bentonite** 4 Other **concrete**  
 Grout Intervals: From 2 ft. to 21 ft., From 21 ft. to 23 ft., From 0 ft. to 2 ft.  
 What is the nearest source of possible contamination:  
 1 Septic tank 4 Lateral lines 7 Pit privy 10 Livestock pens 14 Abandoned water well  
 2 Sewer lines 5 Cess pool 8 Sewage lagoon 11 Fuel storage 15 Oil well/Gas well  
 3 Watertight sewer lines 6 Seepage pit 9 Feedyard 12 Fertilizer storage 16 Other (specify below)  
 13 Insecticide storage **landfill**  
 Direction from well? How many feet? **10**

FROM	TO	LITHOLOGIC LOG	FROM	TO	PLUGGING INTERVALS
0	15	clay - dark brown			
15	20	clay - dark grey			
20	27	clay - greenish grey			
27	33	clay silt - brown			
33	35.6	silt - sand - gravel			

7 CONTRACTOR'S OR LANDOWNER'S CERTIFICATION: This water well was **1) constructed**, (2) reconstructed, or (3) plugged under my jurisdiction and was completed on (mo/day/year) **3-5-91** and this record is true to the best of my knowledge and belief. Kansas Water Well Contractor's License No. **538** This Water Well Record was completed on (mo/day/yr) **3-26-91** under the business name of **Fugro-McClelland** by (signature) *Charles Sprouly*

OFFICE USE ONLY  
T  
R  
EW  
SEC.  
1/4  
1/4  
1/4