


LOCATION OF WATER WELL: Fraction NW 1/4 SW 1/4 SE 1/4 Section Number 25 Township Number T 34 S Range Number R 16 E 4
 County: Montgomery

Distance and direction from nearest town or city street address of well if located within city?

1/8 mi north of North Linden

WATER WELL OWNER: Farmland Industries
 R#, St. Address, Box #: North Linden Board of Agriculture, Division of Water Resources
 City, State, ZIP Code: Coffeyville, KS 67337 Application Number:

LOCATE WELL'S LOCATION WITH AN "X" IN SECTION BOX: DEPTH OF COMPLETED WELL: 21.8 ft. ELEVATION: _____

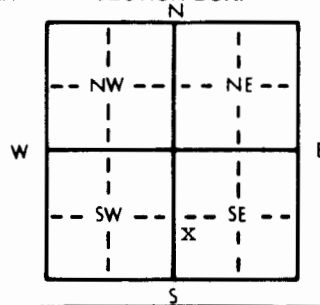

Depth(s) Groundwater Encountered 1. 16 ft. 2. _____ ft. 3. _____ ft.
 WELL'S STATIC WATER LEVEL _____ ft. below land surface measured on mo/day/yr
 Pump test data: Well water was _____ ft. after _____ hours pumping _____ gpm
 Est. Yield _____ gpm: Well water was _____ ft. after _____ hours pumping _____ gpm
 Bore Hole Diameter: 7.25 in. to 21.8 ft., and _____ in. to _____ ft.
 WELL WATER TO BE USED AS: 5 Public water supply 8 Air conditioning 11 Injection well
 1 Domestic 3 Feedlot 6 Oil field water supply 9 Dewatering 12 Other (Specify below)
 2 Irrigation 4 Industrial 7 Lawn and garden only 10 Monitoring well
 Was a chemical/bacteriological sample submitted to Department? Yes _____ No X _____; If yes, mo/day/yr sample was submitted _____
 Water Well Disinfected? Yes _____ No X _____

TYPE OF BLANK CASING USED: 1 Steel 2 PVC 3 RMP (SR) 4 ABS 5 Wrought iron 6 Asbestos-Cement 7 Fiberglass 8 Concrete tile 9 Other (specify below) 10 Stainless Steel
 Blank casing diameter: 2 in. to 19.8 ft., Dia _____ in. to _____ ft., Dia _____ in. to _____ ft.
 Casing height above land surface: 24 in., weight _____ lbs./ft. Wall thickness or gauge No. 0.18 in.
 CASING JOINTS: Glued _____ Clamped _____ Welded _____ Threaded X _____

TYPE OF SCREEN OR PERFORATION MATERIAL: 1 Steel 3 Stainless steel 5 Fiberglass 6 Concrete tile 7 PVC 8 RMP (SR) 9 ABS 10 Asbestos-cement 11 Other (specify) _____ 12 None used (open hole)
 SCREEN OR PERFORATION OPENINGS ARE: 1 Continuous slot 3 Mill slot 6 Wire wrapped 8 Saw cut 11 None (open hole)
 2 Louvered shutter 4 Key punched 7 Torch cut 9 Drilled holes 10 Other (specify) _____

SCREEN-PERFORATED INTERVALS: From 19.8 ft. to 21.8 ft., From _____ ft. to _____ ft.
 GRAVEL PACK INTERVALS: From 17.8 ft. to 21.8 ft., From _____ ft. to _____ ft.

GROUT MATERIAL: 1 Neat cement 2 Cement grout 3 Bentonite 4 Other concrete
 Grout intervals: From 2 ft. to 15.8 ft., From 15.8 ft. to 17.8 ft., From 0 ft. to 2 ft.

What is the nearest source of possible contamination: 1 Septic tank 4 Lateral lines 7 Pit privy 10 Livestock pens 14 Abandoned water well
 2 Sewer lines 5 Cess pool 8 Sewage lagoon 11 Fuel storage 15 Oil well/Gas well
 3 Watertight sewer lines 6 Seepage pit 9 Feedyard 12 Fertilizer storage 16 Other (specify below)
 13 Insecticide storage _____ landfill
 Direction from well? _____ How many feet? 50

FROM	TO	LITHOLOGIC LOG	FROM	TO	PLUGGING INTERVALS
0	7	clay - greenish brown			
7	16	clay - brown			
16	21.8	gravel			

CONTRACTOR'S OR LANDOWNER'S CERTIFICATION: This water well was (1) constructed (2) reconstructed, or (3) plugged under my jurisdiction and was completed on (mo/day/year) 3-6-91 and this record is true to the best of my knowledge and belief. Kansas Water Well Contractor's License No. 538 This Water Well Record was completed on (mo/day/yr) 3-27-91
 Under the business name of Fugro-McClelland by (signature) Charles Shively

INSTRUCTIONS: Use typewriter or ball point pen. PLEASE PRESS FIRMLY and PRINT clearly. Please fill in blanks, underline or circle the correct answers. Send top three copies to Kansas Department of Health and Environment, Bureau of Water, Topeka, Kansas 66620-7320. Telephone: 913-296-5545. Send one to WATER WELL OWNER and retain one for your records.

OFFICE USE ONLY
T
R
E
M
W
SEC.
1/4
1/4
1/4