


1 LOCATION OF WATER WELL: County: Montgomery Fraction: SE 1/4 SE 1/4 SE 1/4 Section Number: 25 Township Number: T 34 S Range Number: R 16 E

Distance and direction from nearest town or city street address of well if located within city?
Coffeyville, KS

2 WATER WELL OWNER: Faerbank Industrial
RR#, St. Address, Box #: P.O. Box 7305 DEPT 141 Board of Agriculture, Division of Water Resources
City, State, ZIP Code: Kansas City Mo 64116-0005 Application Number:

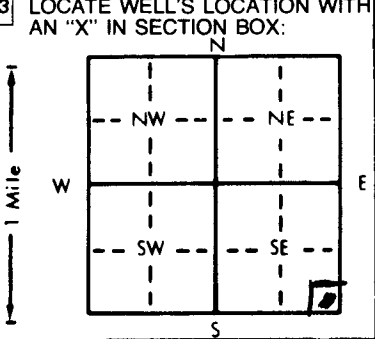

4 DEPTH OF COMPLETED WELL: 22 ft. ELEVATION:
Depth(s) Groundwater Encountered: 1. 10 ft. 2. ft. 3. ft.
WELL'S STATIC WATER LEVEL: ft. below land surface measured on mo/day/yr
Pump test data: Well water was ft. after hours pumping gpm
Est. Yield gpm: Well water was ft. after hours pumping gpm
Bore Hole Diameter: 8 3/4 in. to 22 ft., and in. to ft.
WELL WATER TO BE USED AS:
5 Public water supply 8 Air conditioning 11 Injection well
1 Domestic 3 Feedlot 6 Oil field water supply 9 Dewatering 12 Other (Specify below)
2 Irrigation 4 Industrial 7 Lawn and garden only 10 Monitoring well
Was a chemical/bacteriological sample submitted to Department? Yes No X; If yes, mo/day/yr sample was submitted
Water Well Disinfected? Yes No X

5 TYPE OF BLANK CASING USED:
1 Steel 3 RMP (SR) 5 Wrought iron 8 Concrete tile CASING JOINTS: Glued Clamped
2 PVC 4 ABS 6 Asbestos-Cement 9 Other (specify below) Welded
Blank casing diameter: 2 in. to 7 ft., Dia. in. to ft., Dia. in. to ft.
Casing height above land surface: 24 in., weight lbs./ft. Wall thickness or gauge No. Sch 40
7 Fiberglass Threaded X
TYPE OF SCREEN OR PERFORATION MATERIAL:
1 Steel 3 Stainless steel 5 Fiberglass 8 RMP (SR) 10 Asbestos-cement
2 Brass 4 Galvanized steel 6 Concrete tile 9 ABS 11 Other (specify)
SCREEN OR PERFORATION OPENINGS ARE:
1 Continuous slot 3 Mill slot 5 Gauzed wrapped 8 Saw cut 11 None (open hole)
2 Louvered shutter 4 Key punched 6 Wire wrapped 9 Drilled holes
7 Torch cut 10 Other (specify)
SCREEN-PERFORATED INTERVALS: From 22 ft. to 7 ft., From ft. to ft.
GRAVEL PACK INTERVALS: From 22 ft. to 5 ft., From ft. to ft.

6 GROUT MATERIAL: 1 Neat cement 2 Cement grout 3 Bentonite 4 Other
Grout Intervals: From ft. to ft., From 3 ft. to 0 ft., From 5 ft. to 3 ft.
What is the nearest source of possible contamination:
1 Septic tank 4 Lateral lines 7 Pit privy 10 Livestock pens 14 Abandoned water well
2 Sewer lines 5 Cess pool 8 Sewage lagoon 11 Fuel storage 15 Oil well/Gas well
3 Watertight sewer lines 6 Seepage pit 9 Feedyard 12 Fertilizer storage 16 Other (specify below)
13 Insecticide storage
Direction from well? Well Located on a Refinery How many feet?

FROM	TO	LITHOLOGIC LOG	FROM	TO	PLUGGING INTERVALS
0	10	Brown Silty Clay Moderate S.F.F.			
10	18	Light Brown Silty Clay/Sand Wet			
18	22	Large Gravelly Sand Wet			

7 CONTRACTOR'S OR LANDOWNER'S CERTIFICATION: This water well was (1) constructed, (2) reconstructed, or (3) plugged under my jurisdiction and was completed on (mo/day/year) 4-02-93 and this record is true to the best of my knowledge and belief. Kansas Water Well Contractor's License No. 551 This Water Well Record was completed on (mo/day/yr) 4-30-93 under the business name of Associated Environmental Industries by (signature) *[Signature]*

INSTRUCTIONS: Use typewriter or ball point pen, PLEASE PRESS FIRMLY and PRINT clearly. Please fill in blanks, underline or circle correct answers. Send up three copies to Kansas Department of Health and Environment, Bureau of Water, Topeka, Kansas 66620-0001. Telephone: 913-296-5545. Send one to WATER WELL OWNER and retain one for your records.

000124

OFFICE USE ONLY
T
R
EW
SEC.