


1 LOCATION OF WATER WELL: County: Montgomery Fraction SW 1/4 NW 1/4 SE 1/4 Section Number 25 Township Number T 34 S Range Number R 16 **(EW)**

Distance and direction from nearest town or city street address of well if located within city?
North Linden Street, Coffeyville, Ks.

2 WATER WELL OWNER: Famland Industries - Coffeyville Refinery
 RR#, St. Address, Box # : North Linden Street Board of Agriculture, Division of Water Resources
 City, State, ZIP Code : Coffeyville, Ks. 67337 Application Number:

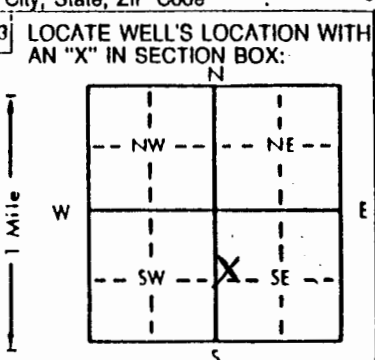

4 DEPTH OF COMPLETED WELL: 36.6 ft. ELEVATION: _____
 Depth(s) Groundwater Encountered 1. 25.6 ft. 2. _____ ft. 3. _____ ft.
 WELL'S STATIC WATER LEVEL _____ ft. below land surface measured on mo/day/yr
 Pump test data: Well water was _____ ft. after _____ hours pumping _____ gpm
 Est. Yield _____ gpm: Well water was _____ ft. after _____ hours pumping _____ gpm
 Bore Hole Diameter: 8 in. to 36.6 ft., and _____ in. to _____ ft.
 WELL WATER TO BE USED AS: 5 Public water supply 8 Air conditioning 11 Injection well
 1 Domestic 3 Feedlot 6 Oil field water supply 9 Dewatering 12 Other (Specify below)
 2 Irrigation 4 Industrial 7 Lawn and garden only **(10) Monitoring well**
 Was a chemical/bacteriological sample submitted to Department? Yes _____ No If yes, mo/day/yr sample was submitted
 Water Well Disinfected? Yes _____ No

5 TYPE OF BLANK CASING USED: 1 Steel 3 RMP (SR) 5 Wrought iron 8 Concrete tile CASING JOINTS: Glued _____ Clamped _____
(2) PVC 4 ABS 6 Asbestos-Cement 9 Other (specify below) Welded _____
 7 Fiberglass Threaded
 Blank casing diameter 2 in. to 21.6 ft. Dia _____ in. to _____ ft. Dia _____ in. to _____ ft.
 Casing height above land surface 24 in. weight _____ lbs./ft. Wall thickness or gauge No. Sch. 40
 TYPE OF SCREEN OR PERFORATION MATERIAL: 7 PVC 10 Asbestos-cement
 1 Steel **(3) Stainless steel** 5 Fiberglass 8 RMP (SR) 11 Other (specify) _____
 2 Brass 4 Galvanized steel 6 Concrete tile 9 ABS 12 None used (open hole)
 SCREEN OR PERFORATION OPENINGS ARE: 5 Gauzed wrapped 8 Saw cut 11 None (open hole)
 1 Continuous slot 3 Mill slot **(6) Wire wrapped .030** 9 Drilled holes
 2 Louvered shutter 4 Key punched 7 Torch cut 10 Other (specify) _____
 SCREEN-PERFORATED INTERVALS: From 36.6 ft. to 21.6 ft., From _____ ft. to _____ ft.
 From _____ ft. to _____ ft., From _____ ft. to _____ ft.
 GRAVEL PACK INTERVALS: From 36.6 ft. to 19.6 ft., From _____ ft. to _____ ft.
 From _____ ft. to _____ ft., From _____ ft. to _____ ft.

6 GROUT MATERIAL: 1 Neat cement **(2) Cement grout** **(3) Bentonite** 4 Other _____
 Grout Intervals: From 19.6 ft. to 4 (bent) ft., From 4 ft. to 0 (cem) ft., From _____ ft. to _____ ft.
 What is the nearest source of possible contamination:
 1 Septic tank 4 Lateral lines 7 Pit privy 10 Livestock pens 14 Abandoned water well
 2 Sewer lines 5 Cess pool 8 Sewage lagoon 11 Fuel storage 15 Oil well/Gas well
 3 Watertight sewer lines 6 Seepage pit 9 Feedyard 12 Fertilizer storage **(16) Other (specify below)**
 _____ Refinery
 Direction from well? _____ at refinery How many feet? _____

FROM	TO	LITHOLOGIC LOG	FROM	TO	PLUGGING INTERVALS
0	2	FILL SILT, SANDY, ROCK CONCRETE			
2	4	SILT SANDY, CLAYEY, TAN/GRAY			MW16
4	10	SILT CLAYEY, DK BRN			
10	12	SILT CLAYEY, LT GRAY/BRN			
12	19	CLAY SILTY, GRAY TO DK BRN			
19	24	CLAY SILTY, OLIVE, TAN, GRAY			
24	31	SILT CLAYEY, TAN TO GRAY			
31	32.5	SAND SILTY, TAN GRAY - OLIVE			
32.5	36.5	GRVL SILTY, SANDY, OLIVE TO GRAY			

7 CONTRACTOR'S OR LANDOWNER'S CERTIFICATION: This water well was **(1)** constructed, (2) reconstructed, or (3) plugged under my jurisdiction and was completed on (mo/day/year) 09-09-93 and this record is true to the best of my knowledge and belief. Kansas Water Well Contractor's License No. 527 This Water Well Record was completed on (mo/day/yr) 10-08-93 under the business name of GeoCore Services, Inc. by (signature) Doc Robt

INSTRUCTIONS: Use typewriter or ball point pen. PLEASE PRESS FIRMLY and PRINT clearly. Please fill in blanks, underline or circle the correct answers. Send top three copies to Kansas Department of Health and Environment, Bureau of Water, Topeka, Kansas 66620-0001. Telephone: 913-296-5545. Send one to WATER WELL OWNER and retain one for your records.