


1 LOCATION OF WATER WELL: County: Montgomery Fraction: NE 1/4 SE 1/4 SE 1/4 Section Number: 25 Township Number: T 34 S Range Number: R 16 **(EW)**

Distance and direction from nearest town or city street address of well if located within city?  
North Linden Street, Coffeyville, Ks.

2 WATER WELL OWNER: Farmland Industries - Coffeyville Refinery  
 RR#, St. Address, Box #: North Linden Street Board of Agriculture, Division of Water Resources  
 City, State, ZIP Code: Coffeyville, Ks. 67337 Application Number:

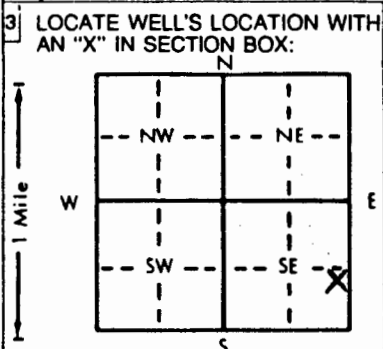

4 DEPTH OF COMPLETED WELL: 17 ft. ELEVATION: .....  
 Depth(s) Groundwater Encountered 1. 11.8 ft. 2. .... ft. 3. .... ft.  
 WELL'S STATIC WATER LEVEL ..... ft. below land surface measured on mo/day/yr .....  
 Pump test data: Well water was ..... ft. after ..... hours pumping ..... gpm  
 Est. Yield ..... gpm: Well water was ..... ft. after ..... hours pumping ..... gpm  
 Bore Hole Diameter: 8 in. to 17 ft., and ..... in. to ..... ft.  
 WELL WATER TO BE USED AS:  
 5 Public water supply 8 Air conditioning 11 Injection well  
 1 Domestic 3 Feedlot 6 Oil field water supply 9 Dewatering 12 Other (Specify below)  
 2 Irrigation 4 Industrial 7 Lawn and garden only **(10)** Monitoring well .....  
 Was a chemical/bacteriological sample submitted to Department? Yes.....No. ; If yes, mo/day/yr sample was submitted  
 Water Well Disinfected? Yes No

5 TYPE OF BLANK CASING USED:  
**(1)** Steel Stainless 3 RMP (SR) 5 Wrought iron 8 Concrete tile CASING JOINTS: Glued ..... Clamped .....  
**(2)** PVC 4 ABS 6 Asbestos-Cement 9 Other (specify below) Welded .....  
 7 Fiberglass Threaded.   
 Blank casing diameter 2 PVC ..... in. to 2 ft., Dia 2.55 in. to 7 ft., Dia ..... in. to ..... ft.  
 Casing height above land surface: 24 in., weight ..... lbs./ft. Wall thickness or gauge No. Sch. 5 SS  
 TYPE OF SCREEN OR PERFORATION MATERIAL:  
 1 Steel **(3)** Stainless steel .030 5 Fiberglass 7 PVC 10 Asbestos-cement  
 2 Brass 4 Galvanized steel 6 Concrete tile 8 RMP (SR) 11 Other (specify) .....  
 12 None used (open hole)  
 SCREEN OR PERFORATION OPENINGS ARE:  
 1 Continuous slot 3 Mill slot 5 Gauzed wrapped 8 Saw cut 11 None (open hole)  
 2 Louvered shutter 4 Key punched **(6)** Wire wrapped .030 9 Drilled holes  
 7 Torch cut 10 Other (specify) .....  
 SCREEN-PERFORATED INTERVALS: From 17 ft. to 7 ft., From ..... ft. to ..... ft.  
 From ..... ft. to ..... ft., From ..... ft. to ..... ft.  
 GRAVEL PACK INTERVALS: From 17 ft. to 5 ft., From ..... ft. to ..... ft.  
 From ..... ft. to ..... ft., From ..... ft. to ..... ft.

6 GROUT MATERIAL: 1 Neat cement **(2)** Cement grout **(3)** Bentonite 4 Other .....  
 Grout Intervals: From 5 ft. to 3 (bent) ft., From 3 ft. to 0 (cem) ft., From ..... ft. to ..... ft.  
 What is the nearest source of possible contamination:  
 1 Septic tank 4 Lateral lines 7 Pit privy 10 Livestock pens 14 Abandoned water well  
 2 Sewer lines 5 Cess pool 8 Sewage lagoon 11 Fuel storage 15 Oil well/Gas well  
 3 Watertight sewer lines 6 Seepage pit 9 Feedyard 12 Fertilizer storage **(16)** Other (specify below)  
 Refinery  
 Direction from well? at refinery How many feet? ?

FROM	TO	LITHOLOGIC LOG	FROM	TO	PLUGGING INTERVALS
0	8	FILL CLAY SILTY, LT & DK GRAY, TAN, GRVLLY			
8	10.7	CLAY SILTY, TAN TO OLIVE GRAY			MW20
10.7	11.7	CLAY SITLY, GRAY			
11.7	13.5	SILTY CLAYEY, GRAY			
13.5	15	SILTY, LT GRAY			
15	17	SILT, V FINE SANDY GRAY/ORANGE MOTTLED			

7 CONTRACTOR'S OR LANDOWNER'S CERTIFICATION: This water well was **(1)** constructed, (2) reconstructed, or (3) plugged under my jurisdiction and was completed on (mo/day/year) 09-10-93 and this record is true to the best of my knowledge and belief. Kansas Water Well Contractor's License No. 527 This Water Well Record was completed on (mo/day/yr) 10-08-93 under the business name of GeoCore Services, Inc. by (signature) Lola Robb

INSTRUCTIONS: Use typewriter or ball point pen. PLEASE PRESS FIRMLY and PRINT clearly. Please fill in blanks, underline or circle the correct answers. Send top three copies to Kansas Department of Health and Environment, Bureau of Water, Topeka, Kansas 66620-0001. Telephone: 913-296-5545. Send one to WATER WELL OWNER and retain one for your records.